

WALTHALL
G 15
2-29-72

MISSISSIPPI
BOARD OF WATER COMMISSIONERS.
416 North State Street
Jackson, Mississippi 39201

WATER WELL DRILLERS LOG

Feb 29 1972 Chute Kewee Walthall
date well completed firm name county well located

LANDOWNER: Chute Kewee
Burnfield -
P.O. Tyntown -
(mailing address)

WELL LOCATION:
sec. 32 T. 2 N. R. 12 E.
8 miles SE of Plattown
(distance) (direction) (nearest town)

WELL PURPOSE: Home
(home, irrigation, municipal, industrial)

WELL COMPLETION DATA:

- (1) diameter (inches) 4"
- (2) total depth (feet) 174
- (3) static water level (feet) _____ below
top of ground. above
- (4) casing plast bottom
(material) (depth)
- _____ If telescope see back.
(size)
- (5) screen 6' 168
(length) (depth to top)
- 4" plast
(size) (material)
- (6) pump 1 HP 20
(HP) (yield gpm)
- Elect
(type power)
- (7) electric log NO
(yes or no)
- NO
(organization running log)
- (8) how well bottom plugged? wood plug

description of formations encountered	from	to
Red Chalk	0	35
Red Chalky Sand	35	83
Small gravel Sand	83	98
chalky sand	98	137
Small gravel Sand	137	144
Red Chalk	144	152
Coarse Sand	152	156
Small gravel Sand	156	174


DRILLERS REMARKS:
New Home

JUL 3 1972

MISS. DEPT. OF
WATER RESOURCES

If well telescopes please
sketch and show depths.

GROUND LEVEL

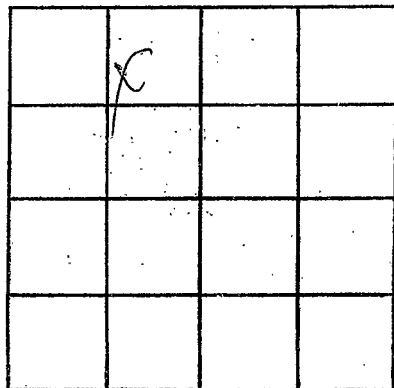

SECTION 32

Please indicate well location X.

ADDITIONAL INFORMATION

If more than one screen,
show locations of each on sketch.