

WALTHALL  
G 18  
5-19-72

MISSISSIPPI  
BOARD OF WATER COMMISSIONERS  
416 North State Street  
Jackson, Mississippi 39201

COPIED

WATER WELL DRILLERS LOG

May 19 1972 Chester Keener Walthall  
date well completed firm name county well located

LANDOWNER: Crestler Magee  
Rt 2, Glenburn  
(mailing address)

description of formations encountered	from	to
Red clay	0	17
Red sand	17	96
Sand & gravel	96	115
Red sand	115	162
Bank chalk	162	178
gravel, chalk sand	178	192
Coarse sand	192	207

WELL LOCATION:  
sec. 78 T. 20 N. R. 12 E.  
8 miles E of Glenburn  
(distance) (direction) (nearest town)

WELL PURPOSE: Home  
(home, irrigation, municipal, industrial)

- WELL COMPLETION DATA:
- (1) diameter (inches) 4 1/2"
  - (2) total depth (feet) 207
  - (3) static water level (feet) 100 below top of ground.
  - (4) casing Plast Bottom  
(material) (depth)
  - \_\_\_\_\_ if telescope see back.  
(size)
  - (5) screen 6' 207'  
(length) (depth to top)
  - 4 1/2" Plast  
(size) (material)
  - (6) pump Sub 12  
(HP) (yield gpm)
  - Elect  
(type power)
  - (7) electric log No  
(yes or no)
  - \_\_\_\_\_ (organization running log)

COPIED

(8) how well bottom plugged: wooden plug


DRILLERS REMARKS: New location

NOV 22 1972

MISS. BOARD OF WATER COMMISSIONERS

If well telescopes please sketch and show depths.

GROUND LEVEL

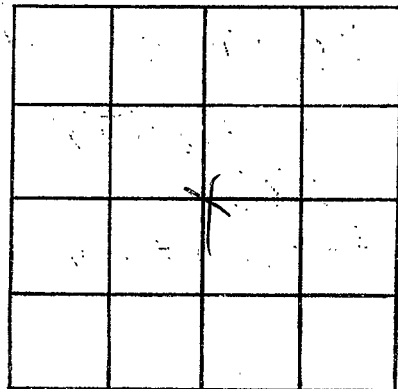

SECTION 28

Please indicate well location X.

ADDITIONAL INFORMATION

Lined area for additional information.

If more than one screen, show locations of each on sketch.

10 20 30 40 50