

WALTHALL  
G 19  
9-17-72

MISSISSIPPI  
BOARD OF WATER COMMISSIONERS  
416 North State Street  
Jackson, Mississippi 39201

**CODED**

WATER WELL DRILLERS LOG

Sept 9 1972 date well completed  
Chester Keenes firm name  
walthall county well located

LANDOWNER: Rufus Stewart  
RFD -  
Tylertown -  
(mailing address)

WELL LOCATION:  
sec. 7 T. 2 N. R. 12 E  
2 miles NNE of Kroya  
(distance) (direction) (nearest town)

WELL PURPOSE: Home  
(home, irrigation, municipal, industrial)

WELL COMPLETION DATA:  
(1) diameter (inches) 4 1/2"  
(2) total depth (feet) 210  
(3) static water level (feet) 93 below top of ground.  
(4) casing Plast. Ballou (material) (depth)  
if telescope see back.  
(5) screen 6" 200" (length) (depth to top)  
4" Plast. (size) (material)  
(6) pump 1/2 HP 12 (yield gpm)  
Elec (type power)  
(7) electric log No. (yes or no)  
(organization running log)

description of formations encountered	from	to
Red clay	0	27
Red Sand	27	106
bed of white chalk	106	168
chalk & small gravel	168	187
fine sand	187	200
Coarse sand & pea gravel	200	210

**CODED**


DEC 1 1972

MISS. RD. OF  
WATER COMMISSIONERS

(8) how well bottom plugged  
wooden plug -  
DRILLERS REMARKS:  
new house.

If well telescopes please  
sketch and show depths.

GROUND LEVEL

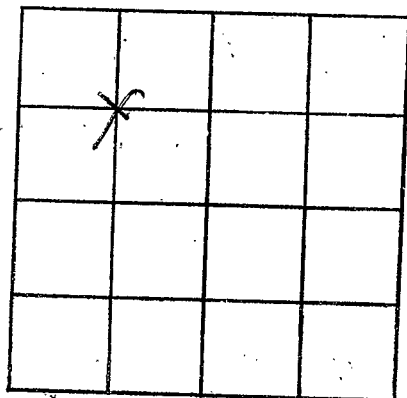

SECTION 7

Please indicate well location X.

ADDITIONAL INFORMATION

If more than one screen,  
show locations of each on sketch.