

WALTHALL
G 20
9-11-72

MISSISSIPPI
BOARD OF WATER COMMISSIONERS
416 North State Street
Jackson, Mississippi 39201

CODED

WATER WELL DRILLERS LOG

Sept 11 1972 date well completed
Chester Reeves firm name
Walthall county well located

LANDOWNER: Art Morris
RFD
Tybertown
(mailing address)

WELL LOCATION:
sec. 36 T. 3 N. R. 12 E
3 miles NE of Dexter
(distance) (direction) (nearest town)

WELL PURPOSE: Home
(home, irrigation, municipal, industrial)

- WELL COMPLETION DATA:
- (1) diameter (inches) 4"
 - (2) total depth (feet) 140
 - (3) static water level (feet) 97 below above top of ground.
 - (4) casing Plastic Babbitt
(material) (depth)
 - _____ if telescope see back.
(size)
 - (5) screen 6' 134'
(length) (depth to top)
 - 1/2" Plastic
(size) (material)
 - (6) pump 1/2 Sub 15
(HP) (yield gpm)
 - elect
(type power)
 - (7) electric log No
(yes or no)
 - _____ (organization running log)

description of formations encountered	from	to
<u>Sandy clay</u>	<u>0</u>	<u>18</u>
<u>Red cherty sand</u>	<u>18</u>	<u>92</u>
<u>Red sand</u>	<u>92</u>	<u>104</u>
<u>Gravel sand</u>	<u>104</u>	<u>107</u>
<u>Red sandy chalk</u>	<u>107</u>	<u>124</u>
<u>Red gravel sand</u>	<u>124</u>	<u>140</u>

CODED


(8) how well bottom plugged
wooden plug

DRILLERS REMARKS:
New house.

DEC 1 1972

If well telescopes please sketch and show depths.

GROUND LEVEL

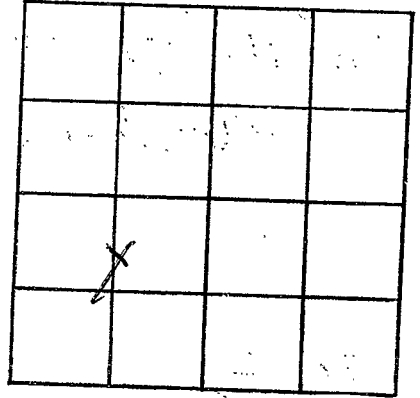

SECTION 36

Please indicate well location X:

ADDITIONAL INFORMATION

If more than one screen,
show locations of each on sketch.