

WALTHALL  
G 21  
9-8-72

MISSISSIPPI  
BOARD OF WATER COMMISSIONERS  
416 North State Street  
Jackson, Mississippi 39201

CODED

WATER WELL DRILLERS LOG

Sept 8 1972 Cheat/Kenes Walthall  
date well completed firm name county well located

LANDOWNER: Quenles  
DeLano  
Rt 2 Tyler Station  
(mailing address)

description of formations encountered	from	to
clay	0	14
Red sand	18	78
Sand & gravel, chalk	78	127
pink chalk	127	130
Sand & gravel	130	176

WELL LOCATION:  
sec. 17 T. 22 R. 12 E.  
2 miles NNE Kemp  
(distance) (direction) (nearest town)

WELL PURPOSE: Home  
(home, irrigation, municipal, industrial)

WELL COMPLETION DATA:

- (1) diameter (inches) 4"
- (2) total depth (feet) 176
- (3) static water level (feet) 122 below above top of ground.
- (4) casing Reast Ballou  
(material) (depth)
- (size) If telescope see back.
- (5) screen 6' 170'  
(length) (depth to top)
- 4" Reast  
(size) (material)
- (6) pump 3/4 sub 1.5  
(HP) (yield gpm)
- elect  
(type power)
- (7) electric log NO  
(yes or no)

CODED

(organization running log)


(8) how well bottom plugged  
wooden plug  
DRILLERS REMARKS:  
New bore

DEC 1 1972

MISS. REG. OFF.  
WATER RESOURCES

If well telescopes please sketch and show depths.

GROUND LEVEL

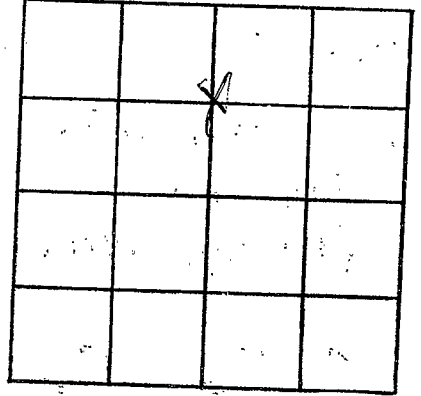

SECTION 2

Please indicate well location X.

ADDITIONAL INFORMATION

If more than one screen, show locations of each on sketch.