

WALTHALL
G 22
9-12-73

MISSISSIPPI
BOARD OF WATER COMMISSIONERS CODED
416 North State Street
Jackson, Mississippi 39201

WATER WELL DRILLERS LOG

9/12 1973 Grines-Ginn Walthall
date well completed firm name county well located

LANDOWNER: Jesse Bullock
Rt 2
Tylertown
(mailing address)

description of formations encountered	from	to
<u>Top Soil</u>	<u>0</u>	<u>1</u>
<u>Clay</u>	<u>1</u>	<u>63</u>
<u>Clay & gravel</u>	<u>63</u>	<u>121</u>
<u>Sand</u>	<u>121</u>	<u>153</u>

WELL LOCATION:
sec 7 T 2 N R 12 E
4 miles S of Robono
(distance) (direction) (nearest town)

WELL PURPOSE: Home
(home, irrigation, municipal, industrial)

- WELL COMPLETION DATA:
- (1) diameter (inches) 2"
- (2) total depth (feet) 153
- (3) static water level (feet) 60 below above top of ground.
- (4) casing Plastic 143ft
(material) (depth)
- 2 if telescope see back.
(size)
- (5) screen 10', 143'
(length) (depth to top)
- 2", Plastic
(size) (material)
- (6) pump 1 6
(HP) (yield gpm)
- Electric
(type power)
- (7) electric log NO
(yes or no)

CODED

(organization running log)


(8) how well bottom plugged
B.W. Yalene

DRILLERS REMARKS:

OGT 9 1973

If well telescopes please sketch and show depths.

GROUND LEVEL

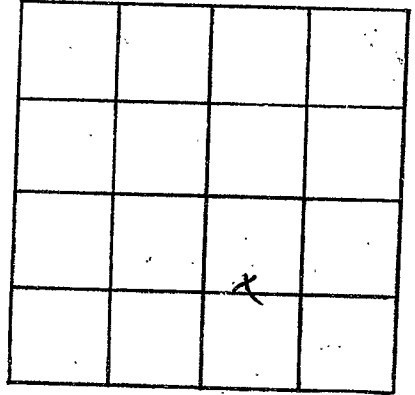

SECTION 2

Please indicate well location X.

ADDITIONAL INFORMATION

If more than one screen, show locations of each on sketch.