

WALTHALL
G23
6-73

MISSISSIPPI
 BOARD OF WATER COMMISSIONERS
 416 North State Street
 Jackson, Mississippi 39201

CODED

WATER WELL DRILLERS LOG

JUNE 1973 E. R. SHEPPARD WALTHALL
 date well completed firm name county well located

LANDOWNER:	description of formations encountered	from	to
<u>LESSEE MAGEE</u>	<u>RED SANDY</u>	<u>0</u>	<u>60'</u>
<u>Rt. 2 TYLERTOWN, MISS.</u>	<u>CLAY GR.</u>	<u>60</u>	<u>90</u>
(mailing address)	<u>SANDY CLAY</u>	<u>90</u>	<u>109'</u>
	<u>GRAVEL</u>		
	<u>SAND</u>		
WELL LOCATION:			
sec <u>28 T. 21 N. R. 12 E.</u>			
<u>8 1/2</u> miles <u>E</u> <u>TYLERTOWN</u>			
(distance) (direction) (nearest town)			
WELL PURPOSE:			
(home, irrigation, municipal, industrial)			
WELL COMPLETION DATA:			
(1) diameter (inches) <u>2"</u>			
(2) total depth (feet) <u>109'</u>			
(3) static water level (feet) <u>92'</u> <u>below</u> <u>above</u> top of ground.			
(4) casing <u>pl.</u> <u>104'</u>			
(material) (depth)			
<u>2"</u> if telescope see back.			
(size)			
(5) screen <u>5'</u> <u>pl.</u>			
(length) (depth to top)			
<u>2"</u> <u>pl.</u>			
(size) (material)			
(6) pump <u>1 1/2</u> <u>7</u>			
(HP) (yield gpm)			
<u>E</u>			
(type power)			
(7) electric log <u>yes</u> or no			
(organization running log)			
(8) how well bottom plugged <u>BWV</u>			
DRILLERS REMARKS:			


CODED

APR 10 1973

MISS. REG. OF
 WATER CONTROL

If well telescopes please
sketch and show depths.

GROUND LEVEL

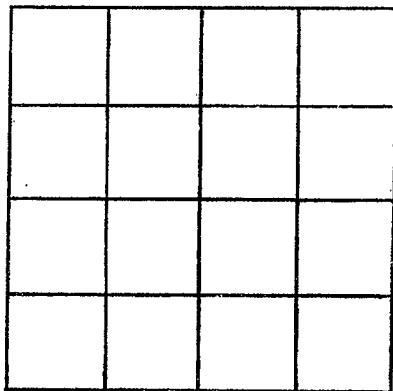

SECTION _____

Please indicate well location X.

ADDITIONAL INFORMATION

If more than one screen,
show locations of each on sketch.