

WALTHALL  
G 24  
6-73

MISSISSIPPI  
BOARD OF WATER COMMISSIONERS  
416 North State Street  
Jackson, Mississippi 39201

CODED

WATER WELL DRILLERS LOG

June 1973 E. B. Sheppard Walthall  
date well completed firm name county well located

LANDOWNER:	description of formations encountered	from	to
Alton Magee Dybertown (mailing address)	BED CLAY WITH 60% SAND GRAVEL BED	0 100	100 142
<b>WELL LOCATION:</b>			
sec <u>21</u> T <u>2</u> N R <u>12</u> E <u>8 1/2</u> miles <u>E</u> of <u>Dybertown</u> (distance) (direction) (nearest town)			
<b>WELL PURPOSE:</b>			
<input checked="" type="checkbox"/> (home) Irrigation, municipal, industrial			
<b>WELL COMPLETION DATA:</b>			
(1) diameter (inches) <u>2"</u>			
(2) total depth (feet) <u>142'</u>			
(3) static water level (feet) <u>90'</u> <sup>below</sup> <sub>above</sub> top of ground.			
(4) casing <u>pl.</u> <u>137'</u> (material) (depth)			
<u>2"</u> (size) if telescope see back.			
(5) screen <u>5'</u> (length) (depth to top)			
<u>2"</u> (size) <u>pl.</u> (material)			
(6) pump <u>1 1/2</u> (HP) <u>7</u> (yield gpm)			
<u>E</u> (type power)			
(7) electric log <input checked="" type="checkbox"/> (yes or no)			
(organization running log)			
(8) how well bottom plugged <u>BUN</u>			
<b>DRILLERS REMARKS:</b>			


CODED

OCT 10 1973

REGS. BD. OF  
WATER COM.

If well telescopes please  
sketch and show depths.

GROUND LEVEL

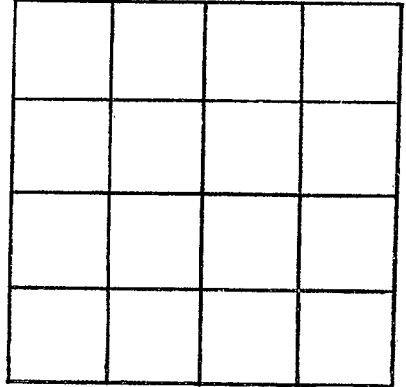

SECTION \_\_\_\_\_

Please indicate well location X.

ADDITIONAL INFORMATION

If more than one screen,  
show locations of each on sketch.