

WALTHALL
G 25
9-15-73

MISSISSIPPI
BOARD OF WATER COMMISSIONERS
416 North State Street
Jackson, Mississippi 39201

CODED

WATER WELL DRILLERS LOG

9/15 1973 James - Geiss Walthall
date well completed firm name county well located

LANDOWNER: Matthew Lowndes
Rt # 2
Vicksburg, Miss.
(mailing address)

description of formations encountered	from to	
<u>top soil</u>	0	8"
<u>clay</u>	8"	45"
<u>clay & sand</u>	45	140
<u>sand</u>	140	175

WELL LOCATION:
sec 6 T 2 N R 12 E
3 miles SW of Kopona
(distance) (direction) (nearest town)

WELL PURPOSE: Home
(home, irrigation, municipal, industrial)

WELL COMPLETION DATA:

- (1) diameter (inches) 4"
 - (2) total depth (feet) 175
 - (3) static water level (feet) 107 below above top of ground
 - (4) casing Plastic 165'
(material) (depth)
4" If telescope see back.
(size)
 - (5) screen 10' 165
(length) (depth to top)
4" Plastic
(size) (material)
 - (6) pump 3/4-11 10
(HP) (yield gpm)
Elec.
(type power)
 - (7) electric log No.
(yes or no)
- (organization running log)
- (8) how well bottom plugged BW valve.


CODED

DRILLERS REMARKS:

NOT 0 10/20 10/20

If well telescopes please sketch and show depths.

GROUND LEVEL

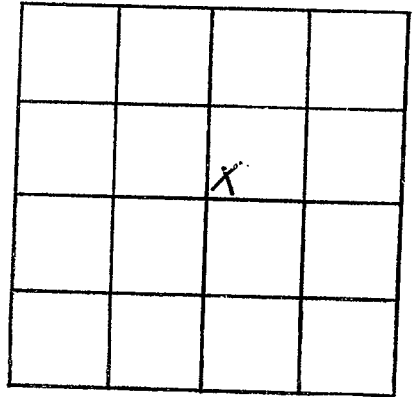

SECTION _____

Please indicate well location X.

ADDITIONAL INFORMATION

If more than one screen,
show locations of each on sketch.