

WALTHALL
G76
8-22-73

MISSISSIPPI
BOARD OF WATER COMMISSIONERS
416 North State Street
Jackson, Mississippi 39201

CODED

WATER WELL DRILLERS LOG

Quinn - Quinn Walthall
firm name county well located

8/20/73 19
date well completed

LANDOWNER:
Inez Oatis
Rt. 2, Tuletown, Miss.
(mailing address)

description of formations encountered	from	to
<u>Top soil</u>	<u>0</u>	<u>1</u>
<u>Clay</u>	<u>1</u>	<u>36</u>
<u>Clay gravel</u>	<u>36</u>	<u>74</u>
<u>Sand & gravel</u>	<u>74</u>	<u>163</u>

WELL LOCATION:
sec. 30 T. 2N R. 12E
2NE #
4 1/2 miles S. of Kokone
(distance) (direction) (nearest town)

WELL PURPOSE: Home
(home, irrigation, municipal, industrial)

- WELL COMPLETION DATA:
- (1) diameter (inches) 2"
 - (2) total depth (feet) 163 ft.
 - (3) static water level (feet) 90 below above top of ground.
 - (4) casing Plastic, 153
(material) (depth)
(size) if telescope see back.
 - (5) screen 10 ft. 153 ft.
(length) (depth to top)
2" Plastic
(size) (material)
 - (6) pump 1 6
(HP) (yield gpm)
Elec.
(type power)
 - (7) electric log _____
(yes or no)
(organization running log)
 - (8) how well bottom plugged
130 Valve


CODED

DRILLERS REMARKS:

MISSISSIPPI
BOARD OF WATER COMMISSIONERS
JUL 20 1973
MISS. AN. OF
WATER COMMISSIONERS

If well telescopes please sketch and show depths.

GROUND LEVEL

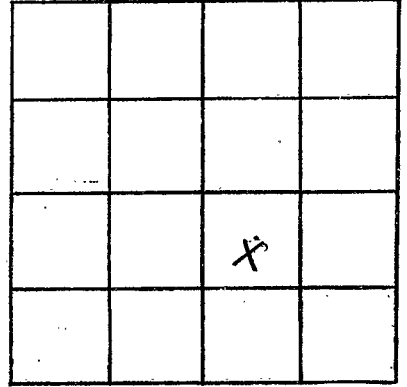

SECTION 28 8

Please indicate well location X.

ADDITIONAL INFORMATION

If more than one screen,
show locations of each on sketch.