

WALTHALL
 627
 9/73

MISSISSIPPI
 BOARD OF WATER COMMISSIONERS
 416 North State Street
 Jackson, Mississippi 39201

WATER WELL DRILLERS LOG

Sept. 1973 E.B. Sheppard **CODED** Walthall
 date well completed firm name county well located

LANDOWNER:
 J.W. Magee
 Rt. 2 - Zylertown, MS
 (mailing address)

| description of formations encountered | from | to |
|---------------------------------------|------|-----|
| RED SANDY CLAY | 0 | 80 |
| LOOSE PEA SH + SAND | 80 | 142 |

WELL LOCATION:
 sec 19 T 2 N R 12 E OK
 S W
 6 miles E Zylertown
 (distance) (direction) (nearest town)

WELL PURPOSE:
 (home, irrigation, municipal, industrial)

- WELL COMPLETION DATA:
- (1) diameter (inches) 2"
 - (2) total depth (feet) 142'
 - (3) static water level (feet) 112' ^{below} top of ground
 - (4) casing: pl. 137' (material) (depth)
 2" (size) If telescope see back.
 - (5) screen 5' (length) (depth to top)
 2" (size) pl. (material)
 - (6) pump 1 1/2 (HP) 8 (yield gpm)
 E (type power)
 - (7) electric log (yes or no)
 - (organization running log)
 - (8) how well bottom plugged BWV


DRILLERS REMARKS:

CODED

RECEIVED
 FEB 9 1974
 MISS. Bd. OF WATER COMMISSIONERS

If well scopes please sketch and show depths.

GROUND LEVEL

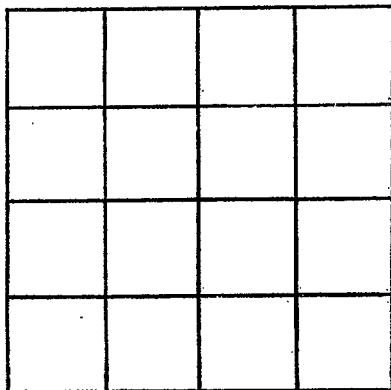

SECTION _____

Please indicate well location X.

ADDITIONAL INFORMATION

If more than one screen, show locations of each on sketch.