

WALTHALL
G 79
5174

MISSISSIPPI
BOARD OF WATER COMMISSIONERS
416 North State Street
Jackson, Mississippi 39201

CODED

WATER WELL DRILLERS LOG

May 19 74 E.B. Sherrard Walthall
date well completed firm name county well located

LANDOWNER:
Sarah Weary
Rt. 2 - Iylertown, Miss.
(mailing address)

description of formations encountered	from	to
RED SANDY CLAY	0	70'
WHITE SAND & GRAVEL	70	123'

WELL LOCATION:
sec 30 T 20N R 12E
S W
6 miles E Iylertown
(distance) (direction) (nearest town)

WELL PURPOSE:
(home) irrigation, municipal, industrial

CODED

- WELL COMPLETION DATA:
- diameter (inches) 2"
 - total depth (feet) 123'
 - static water level (feet) 70' ^{below}/_{above} top of ground.
 - casing pl. 118' (material) (depth)
2" (size) if telescope see back.
 - screen 5' (length) (depth to top)
2" (size) pl. (material)
 - pump 1 (HP) 7 (yield gpm)
E (type power)
 - electric log (yes or no) no
(organization running log)
 - how well bottom plugged BWV


DECEMBER 15 1974
JUL - 1 1974

MISS. BD. OF WATER COMMISSIONERS

DRILLERS REMARKS:

If well telescopes please sketch and show depths.

GROUND LEVEL

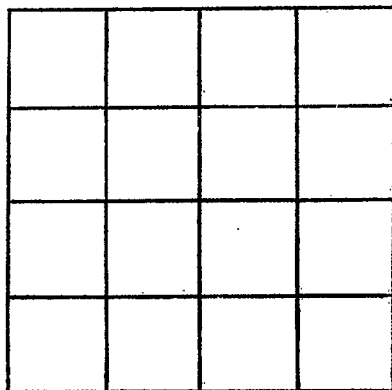

SECTION _____

Please indicate well location X.

ADDITIONAL INFORMATION

If more than one screen,
show locations of each on sketch.