

WALTHALL
 G 30
 5-1-74

MISSISSIPPI
 BOARD OF WATER COMMISSIONERS
 416 North State Street
 Jackson, Mississippi 39201

WATER WELL DRILLERS LOG

CODED

5-1 1974 Miner - Miner Walthall
 date well completed firm name county well located

LANDOWNER:
Emma Magee
Rt. 2 Julesburg
 (mailing address) Miss.

description of formations encountered	from	to
<u>Top Soil</u>	<u>0</u>	<u>1</u>
<u>Clay</u>	<u>1</u>	<u>25</u>
<u>clay & gravel</u>	<u>25</u>	<u>55</u>
<u>Chalk</u>	<u>55</u>	<u>80</u>
<u>Sand</u>	<u>80</u>	<u>107</u>

WELL LOCATION:
 sec 5 T 2 N R 12 E
5 miles SW of Kokomo
 (distance) (direction) (nearest town)

WELL PURPOSE: Home
 (home, irrigation, municipal, industrial)

- WELL COMPLETION DATA:
- (1) diameter (inches) 2"
 - (2) total depth (feet) 107
 - (3) static water level (feet) 92 below top of ground.
 - (4) casing plastic, 97,
 (material) (depth)
2" if telescope see back.
 (size)
 - (5) screen 10', 97
 (length) (depth to top)
2", plastic
 (size) (material)
 - (6) pump 1 6
 (HP) (yield gpm)
elec
 (type power)
 - (7) electric log No
 (yes or no)
No
 (organization running log)
 - (8) how well bottom plugged
But valve

CODED


RECORDED
 INDEXED
 DEC 26 1974

MISS. Bd. OF WATER COMM.

DRILLERS REMARKS:

If well telescopes please sketch and show depths.

GROUND LEVEL

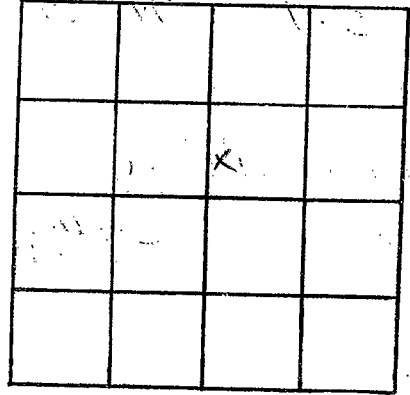

SECTION _____

Please indicate well location X.

ADDITIONAL INFORMATION

If more than one screen, show locations of each on sketch.