

WALTHALL
G 31
2-13-75

MISSISSIPPI
BOARD OF WATER COMMISSIONERS
416 North State Street
Jackson, Mississippi 39201

CODED

WATER WELL DRILLERS LOG

Feb 13 1975 Chuter-Kramer Walthall
date well completed firm name county well located

LANDOWNER:
Ted Bracey
Rt 1, Fishtown
(mailing address)

WELL LOCATION:
sec. 18 T. 2 N. R. 12 E.
7 miles N-NE of Fishtown
(distance) (direction) (nearest town)

WELL PURPOSE: Home
(home, irrigation, municipal, industrial)

WELL COMPLETION DATA:
(1) diameter (inches) 4
(2) total depth (feet) 160
(3) static water level (feet) 91 below top of ground.
(4) casing Plastic Bottom
(material) (depth)
(size) If telescope see back.
(5) screen 6 154
(length) (depth to top)
4" Plastic
(size) (material)
(6) pump 15
(HP) (yield gpm)
elect
(type power)
(7) electric log no
(yes or no)
(organization running log)
(8) how well bottom plugged
Woods Plug

DRILLERS REMARKS:
all well pumped
done

description of formations encountered	from	to
<u>Red clay</u>	<u>0</u>	<u>18</u>
<u>Red sand gravel</u>	<u>18</u>	<u>54</u>
<u>Gravel some sand</u>	<u>54</u>	<u>98</u>
<u>Red Chalk</u>	<u>98</u>	<u>119</u>
<u>Aid Chalky sand</u>	<u>119</u>	<u>140</u>
<u>Red gravel & sand</u>	<u>140</u>	<u>160</u>

CODED


DISCOVERED

FEB 21 1975

MISS. BU. OF WATER

If well telescopes please sketch and show depths.

GROUND LEVEL

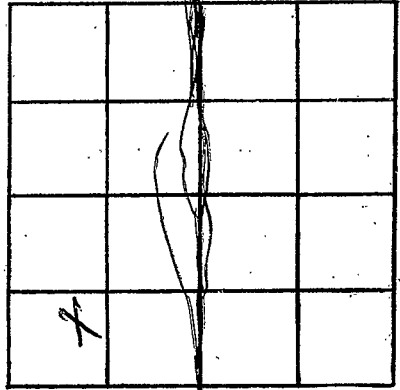

SECTION 18

Please indicate well location X.

ADDITIONAL INFORMATION

If more than one screen, show locations of each on sketch.