

WALTHALL
 # 32
 4-3-74

MISSISSIPPI
 BOARD OF WATER COMMISSIONERS
 416 North State Street
 Jackson, Mississippi 39201

CODED

WATER WELL DRILLERS LOG

April 3 1974 Chesters Lewis Walthall
 date well completed firm name county well located


LANDOWNER: <u>Marcus Green</u>	description of formations encountered	from	to
<u>Rnogo</u> <u>Rt Yuletown</u> (mailing address)			
WELL LOCATION: sec. <u>7</u> T. <u>2</u> N R. <u>12</u> E ^{13y}	<u>Red Sandy clay</u>	<u>0</u>	<u>28</u>
<u>2</u> miles <u>north</u> of <u>Rnogo</u> (distance) (direction) (nearest town)	<u>Red loam sand</u>	<u>28</u>	<u>147</u>
WELL PURPOSE: <u>house</u> (home, irrigation, municipal, industrial)	<u>Red gravel sand</u>	<u>147</u>	<u>160</u>
WELL COMPLETION DATA: (1) diameter (inches) <u>4"</u>			
(2) total depth (feet) <u>160</u>			
(3) static water level (feet) <u>120</u> ^{above} below top of ground			
(4) casing <u>Plast Bottom</u> (material) (depth)			
(size) If telescope see back.			
(5) screen <u>6'</u> <u>154</u> (length) (depth to top)			
(size) (material) <u>Plast</u>			
(6) pump <u>1/2 sub</u> <u>15</u> (HP) (yield gpm)			
(type power)			
(7) electric log <u>No</u> (yes or no)			
(organization running log)			
(8) how well bottom plugged <u>wooden plug</u>			
DRILLERS REMARKS: <u>New house -</u>			

CODED

RECEIVED
 FEB 12 1975
 MISS. BD. OF WATER COMMISSIONERS

If well telescopes please sketch and show depths.

GROUND LEVEL

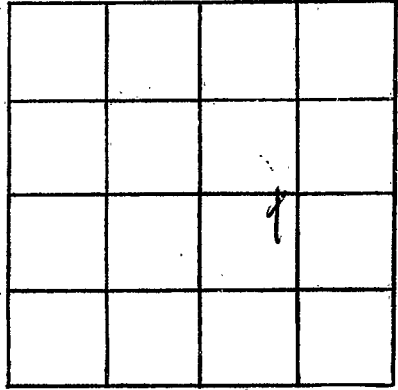

SECTION 7

Please indicate well location X.

ADDITIONAL INFORMATION

If more than one screen, show locations of each on sketch.