

Walthall
 G 34
 5-30-75

MISSISSIPPI
 BOARD OF WATER COMMISSIONERS
 416 North State Street
 Jackson, Mississippi 39201

CODED

WATER WELL DRILLERS LOG

5-30 1975
 date well completed

Coriner - Cinn
 firm name

Walthall
 county well located

LANDOWNER:

Emitt Taylor Rt. 2
 Tylertown, Miss.
 (mailing address)

description of formations
 encountered

from to

Top Soil 0 1
 Clay 1 75
 Chalk 75 92
 Sand 92 120

WELL LOCATION:

sec. 6 T. 22 N R. 12 E 13W
 4 miles SW of Kolow
 (distance) (direction) (nearest town)

WELL PURPOSE: Home
 (home, irrigation, municipal, industrial)

WELL COMPLETION DATA:

- (1) diameter (inches) 4"
- (2) total depth (feet) 120'
- (3) static water level (feet) 85' below above top of ground.
- (4) casing plastic, 110'
 (material) (depth)
 4" if telescope see back.
 (size)
- (5) screen 10', 110'
 (length) (depth to top)
 4" PLASTIC
 (size) (material)
- (6) pump 3/4 (HP) (yield gpm)
 elec.
 (type power)
- (7) electric log NO
 (yes or no)

(organization running log)

(8) how well bottom plugged
 BW VALVE


DRILLERS REMARKS:

DECEMBER 12 1975

MISS. RD. OF WATER COMM.

If well telescopes please
sketch and show depths.

GROUND LEVEL

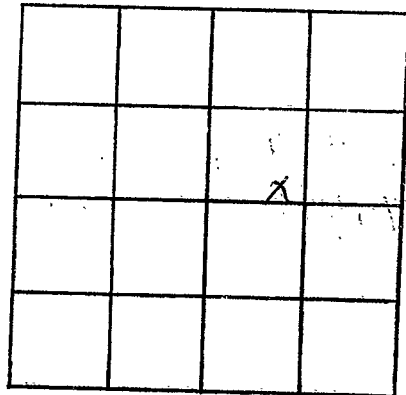

SECTION _____

Please indicate well location X.

ADDITIONAL INFORMATION

If more than one screen,
show locations of each on sketch.