

WALTHALL
 B36
 1/25/78

MISSISSIPPI
 BOARD OF WATER COMMISSIONERS
 416 North State Street
 Jackson, Mississippi 39201

CODED

WATER WELL DRILLERS LOG

1/25/78 19 Griner Drilling Service Walthall
 date well completed firm name county well located

LANDOWNER: Texaco Inc.
#1 Fernwood Lumber Co. E
 (mailing address)

description of formations encountered	from	to
<u>Clay</u>	<u>0</u>	<u>62</u>
<u>Sand & Gravel</u>	<u>63</u>	<u>105</u>
<u>Gravel Sand & Pea Gravel</u>	<u>106</u>	<u>345</u>
<u>Clay</u>	<u>346</u>	<u>357</u>

WELL LOCATION:
 sec. 22 T. 2 (N) R. 12 (E)
1500' S + 1140' E of NW cor of Kokomo
 (distance) miles (direction) of (nearest town)

WELL PURPOSE:
 (home, irrigation, municipal, industrial)

WELL COMPLETION DATA:
 (1) diameter (inches) 3"
 (2) total depth (feet) 357'
 (3) static water level (feet) 75 below above top of ground.
 (4) casing Steel 340'
 (material) (depth)
3"
 (size) If telescope see back.
 (5) screen 40' 300'
 (length) (depth to top)
3" Perforated Pipe
 (size) (material)
 (6) pump 80
 (HP) (yield gpm)
AC
 (type power)
 (7) electric log NO
 (yes or no)
 (organization running log)
 (8) how well bottom plugged orange
Peel


DRILLERS REMARKS:

RECEIVED
 FEB 10 1978

MISS. BD. OF WATER COMM

If well telescopes please
sketch and show depths.

GROUND LEVEL

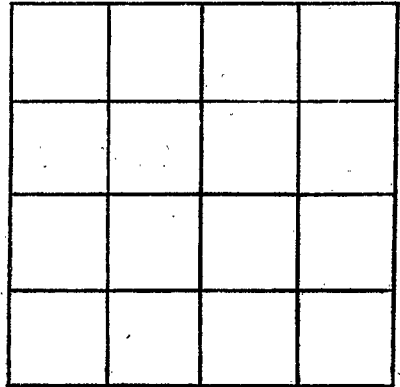

SECTION _____

Please indicate well location X.

ADDITIONAL INFORMATION

If more than one screen,
show locations of each on sketch.