

WATHALL
 537
 115719

MISSISSIPPI
 BOARD OF WATER COMMISSIONERS
 416 North State Street
 Jackson, Mississippi 39201

WATER WELL DRILLERS LOG

1/5/79 19 Griner Drilling Service Wathall
 date well completed firm name county well located

LANDOWNER:
 Texaco Oil Company
 P.O. Box 7
 Harvey, La.
 (mailing address)

WELL LOCATION: 1500'S + 1500' W
 sec. 17 T. 2 R. 12 of
 Knoxville Field NE/cor.
 5 miles SW of Kokomo
 (distance) (direction) (nearest town)

WELL PURPOSE: oil field supply
 (home, irrigation, municipal, industrial)

- WELL COMPLETION DATA:
- (1) diameter (inches) 4"
 - (2) total depth (feet) 360'
 - (3) static water level (feet) 120' ^{below} above top of ground.
 - (4) casing Steel 357' (material) (depth)
 3" (size) if telescope see back.
 - (5) screen 42' 315' (length) (depth to top)
 3" perforated (size) (material)
 - (6) pump 80 (HP) (yield gpm)
 AC (type power)
 - (7) electric log (yes or no)
 - (organization running log)
 - (8) how well bottom plugged orange peel

description of formations encountered	from	to
Clay, sand, + P. Gravel	0	30
Sand + P. Gravel	30	84
clay, sand, + P. Gravel	84	105
Sand + P. Gravel	105	116
clay, sand, + P. Gravel	116	126
Sand + P. Gravel	126	179
sand, P. Gravel + clay	179	210
Sand, P. Gravel, breakers of clay	210	360


DRILLERS REMARKS:

RECEIVED
 JAN 24 1978

MISS. BD. OF WATER COMMISSIONERS

If well telescopes please sketch and show depths.

GROUND LEVEL

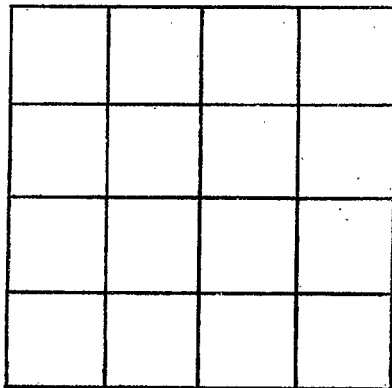

SECTION _____

Please indicate well location X.

ADDITIONAL INFORMATION

If more than one screen, show locations of each on sketch.