

WALTHALL  
 E 38  
 V 30/79

MISSISSIPPI  
 BOARD OF WATER COMMISSIONERS  
 416 North State Street  
 Jackson, Mississippi 39201

CODED

WATER WELL DRILLERS LOG

1-30-79 Griner Drilling Wathall  
 date well completed firm name county well located

LANDOWNER:  
 Browning & Welch  
 144 Standard Life Bldg.  
 Jackson, MS  
 (mailing address)

description of formations encountered	from	to
Chalk	0	25
sand & gravel	25	340

WELL LOCATION: 1500' N & 1144' W  
 sec. 6 T. 26 S R. 12 E of  
 W SW/CO  
 15 miles west of Columbia  
 (distance) (direction) (nearest town)

WELL PURPOSE: oil field supply  
 (home, irrigation, municipal, industrial)

WELL COMPLETION DATA:

(1) diameter (inches) 3" oil field

(2) total depth (feet) 340'

(3) static water level (feet) 150' below top of ground.

(4) casing steel 340'  
 (material) (depth)

3" if telescope see back.  
 (size)

(5) screen 42' 298'  
 (length) (depth to top)

3" perforated  
 (size) (material)

(6) pump 65  
 (HP) (yield gpm)

AC  
 (type power)

(7) electric log  
 (yes or no)

(organization running log)

CODED

(8) how well bottom plugged  
 peel orange

MISS. Board of Water Commis


FEB 13 1979

DRILLERS REMARKS:

RECEIVED

If well telescopes please sketch and show depths.

GROUND LEVEL

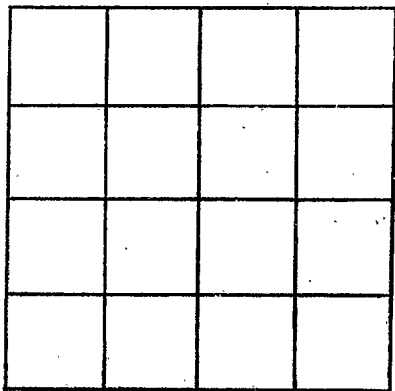

SECTION \_\_\_\_\_

Please indicate well location X.

ADDITIONAL INFORMATION

A series of horizontal lines for recording additional information, starting below the 'ADDITIONAL INFORMATION' header and extending to the bottom of the page.

If more than one screen, show locations of each on sketch.