

WALTHALL

G 39

3-16-79

MISSISSIPPI BOARD OF WATER COMMISSIONERS
416 North State Street
Jackson, Mississippi 39201

CODED

WATER WELL DRILLERS LOG

date well completed

firm name

county well located

3-16-79 *Greiner Drilling* *Walthall*

LANDOWNER:

Marion Drilling
P.O. Box 16006
Mobile, Alabama
(mailing address)

description of formations encountered

from

to

<i>Clay and sand</i>	<i>0</i>	<i>21</i>
<i>Sand</i>	<i>21</i>	<i>84</i>
<i>sand and chalk</i>	<i>84</i>	<i>105</i>
<i>sand</i>	<i>105</i>	<i>126</i>
<i>gravel</i>	<i>126</i>	<i>168</i>
<i>sand and chalk</i>	<i>168</i>	<i>189</i>
<i>chalk</i>	<i>189</i>	<i>210</i>
<i>chalk and sand</i>	<i>210</i>	<i>231</i>
<i>sand</i>	<i>231</i>	<i>336</i>

WELL LOCATION:

sec. *36* T. *20* R. *120*
1600' N & *2300' E* of
miles *5 1/2* miles (distance) (direction) (nearest town)
SW cor

WELL PURPOSE:

(home, irrigation, municipal, industrial)

WELL COMPLETION DATA:

- (1) diameter (inches) *3"*
- (2) total depth (feet) *336'*
- (3) static water level (feet) *120'* ^{*6' SW*} above top of ground.
- (4) casing *steel*, *336'*
(material) (depth)
3" if telescope see back.
(size)
- (5) screen *42'*, *294'*
(length) (depth to top)
3", *perforated*
(size) (material)
- (6) pump *—*, *80*
(HP) (yield gpm)
AC
(type power)
- (7) electric log *—*
(yes or no)
—
(organization running log)

- (8) how well bottom plugged *orange*
peel

DRILLERS REMARKS:


Miss. Board of Water Comm.

MAR 22 1979

RECEIVED

If well telescopes please sketch and show depths.

GROUND LEVEL

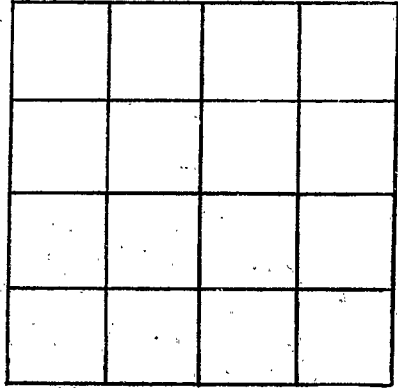

SECTION _____

Please indicate well location X.

ADDITIONAL INFORMATION

A series of horizontal lines for recording additional information.

If more than one screen, show locations of each on sketch.