

Walthall
G43
5-17-80

MISSISSIPPI
BOARD OF WATER COMMISSIONERS
416 North State Street
Jackson, Mississippi 39201

WATER WELL DRILLERS LOG

CODED

5-17-80 Griner Drilling Walthall

date well completed

firm name

county well located

LANDOWNER:
Texaco Oil Co.
P.O. Box 7
Harvey, La
(mailing address)

description of formations encountered	from	to
clay	0	105
sand-gravel	105	357
clay	357	399

WELL LOCATION: 1500' N + 1150' W
 No F/ Fernwood Lumber Co. 22 2 N R 120 of W 56/100
 Knoxville Field
 (distance) (direction) (nearest town)

WELL PURPOSE: oil field supply
 (home, irrigation, municipal, industrial)

CODED

WELL COMPLETION DATA:

(1) diameter (inches) 4"

(2) total depth (feet) 399'

(3) static water level (feet) 75' below top of ground

(4) casing steel 357'
 (material) (depth)
 4" If telescope see back.
 (size)

(5) screen 42' 315'
 (length) (depth to top)
 4" perforated
 (size) (material)

(6) pump 80
 (HP) (yield gpm)
 AC
 (type power)

(7) electric log _____
 (yes or no)

 (organization running log)

DEPT. OF NATURAL RESOURCES
BUREAU OF LAND & WATER RESOURCES

(8) how well bottom plugged Orange
 peel


MAY 23 1980

DRILLERS REMARKS:

RECEIVED

If well telescopes please sketch and show depths.

GROUND LEVEL

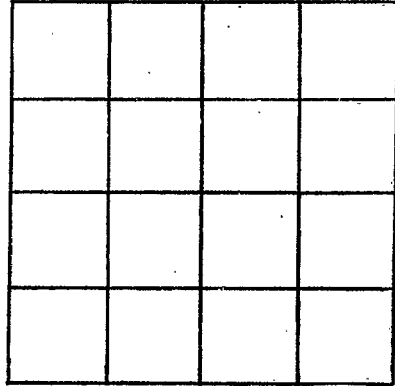

SECTION _____

Please indicate well location X.

ADDITIONAL INFORMATION

If more than one screen, show locations of each on sketch.