

WALTHALL  
 G-44  
 7/29/80  
 7-29-80

MISSISSIPPI  
 BOARD OF WATER COMMISSIONERS  
 416 North State Street  
 Jackson, Mississippi 39201

CODED

WATER WELL DRILLERS LOG

*Trumer Drilling Service, Inc* *Walthall*  
 firm name county well located

date well completed

LANDOWNER:  
*Solo Petroleum*  
*P.O. Box 51468*  
*Lafayette, La. 70505*  
 (mailing address)

description of formations encountered	from	to
<i>sand - pea gravel</i>	<i>0</i>	<i>84</i>
<i>gravel, sand,</i>	<i>84</i>	<i>150</i>
<i>clay</i>		
<i>sand - pea gravel</i>	<i>150</i>	<i>340</i>
<i>clay and sand</i>	<i>340</i>	<i>375</i>

WELL LOCATION: *1500'S* *1135'E* of  
*21* T *20* N R *12* E NW/4  
*Kapona*  
 (distance) (direction) of (nearest town)

*No 1*  
*Bulloch*

WELL PURPOSE: *oil field supply*  
 (home, irrigation, municipal, industrial)

WELL COMPLETION DATA:

- (1) diameter (inches) *3"*
- (2) total depth (feet) *345'*
- (3) static water level (feet) *65'* <sup>below</sup> <sub>above</sub> top of ground.
- (4) casing *steel*, *340'*  
 (material) (depth)  
*3"*  
 (size) if telescope see back.
- (5) screen *42'*, *298'*  
 (length) (depth to top)  
*3"*, *perforated*  
 (size) (material)
- (6) pump *75-80*  
 (HP) (yield gpm)  
*AC*  
 (type power)
- (7) electric log *—*  
 (yes or no)

CODED

(organization running log)

(8) how well bottom plugged *orange*  
*peel*

DEPT. OF NATURAL RESOURCES  
 BUREAU OF LAND & WATER RESOURCES


AUG 6 1980

RECEIVED

DRILLERS REMARKS:

If well telescopes please  
sketch and show depths.

GROUND LEVEL

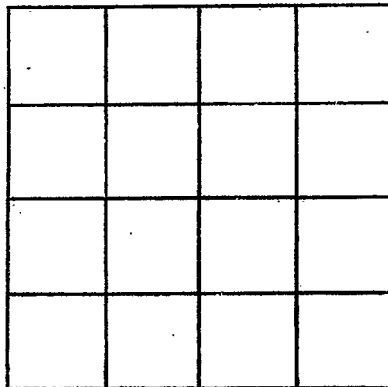

SECTION \_\_\_\_\_

Please indicate well location X.

ADDITIONAL INFORMATION

If more than one screen,  
show locations of each on sketch.