

WALTHALL

G 45
10-20-80

MISSISSIPPI
BOARD OF WATER COMMISSIONERS
416 North State Street
Jackson, Mississippi 39201

CODED

WATER WELL DRILLERS LOG

Griner Drilling Service, Inc. Walthall

date well completed

firm name

county well located

LANDOWNER:
AND Production
620 North St.
Columbus, Mi.
Jackson (mailing address)

description of formations encountered	from	to
clay, sand	0	119
sands, gravel	119	350

WELL LOCATION: 1500' N + 1138' E
No 1 McCain et al. 2 1/2 miles S of South of New Hope
R 12 E of Swilco

WELL PURPOSE: oil field
(home, irrigation, municipal, industrial, supply)

WELL COMPLETION DATA:

- (1) diameter (inches) 3"
- (2) total depth (feet) 350'
- (3) static water level (feet) 60' below top of ground
- (4) casing steel 336' (material) (depth)
3" (size) if telescope see back.
- (5) screen 42' 294' (length) (depth to top)
3" perforated (size) (material)
- (6) pump 75 (HP) (yield gpm)
ac (type power)
- (7) electric log (yes or no)

(organization running log)

(8) how well bottom plugged none
peel

DEPT. OF NATURAL RESOURCES
BUREAU OF LAND & WATER RESOURCES


OCT 28 1980

DRILLERS REMARKS:

RECEIVED

If well telescopes please sketch and show depths.

GROUND LEVEL

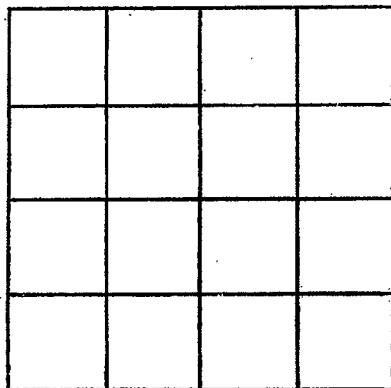

SECTION _____

Please indicate well location X.

ADDITIONAL INFORMATION

If more than one screen, show locations of each on sketch.