

MISSISSIPPI DEPARTMENT OF NATURAL RESOURCES

Bureau of Land and Water Resources

Southport Mall

P.O. Box 10631

Jackson, Mississippi 39209

WATER WELL DRILLERS LOG

WALTHALL
15 47
4-24-82

April 24 19 82 Reems Miller Walthall
 date well completed firm name county well located


LANDOWNER:	description of formations encountered	from	to
<u>J. C. Knippers</u> <u>Tylertown</u> (mailing address)	<u>sandy gravel</u>	<u>0</u>	<u>30</u>
WELL LOCATION: sec. <u>24</u> T <u>2</u> N R <u>9</u> E <u>at Walker Bridge</u> (distance) miles (direction) (nearest town)	<u>white chalk</u>	<u>30</u>	<u>75</u>
WELL PURPOSE: <u>Camp</u> (home, irrigation, municipal, industrial)	<u>fine cherty sand</u>	<u>75</u>	<u>145</u>
WELL COMPLETION DATA:	<u>fine gravelly sand</u>	<u>145</u>	<u>173</u>
(1) diameter (inches) <u>4"</u>			
(2) total depth (feet) <u>173</u>			
(3) static water level (feet) <u>Below</u> above top of ground.			
(4) casing <u>plaster bottom</u> (material) (depth)			
if telescope see back. (size)			
(5) screen <u>10'</u> <u>16 3/4'</u> (length) (depth to top)			
4" plaster (size) (material)			
(6) pump <u>weather</u> (30) (HP) (yield gpm)			
<u>1/2 HP</u> (type power)			
(7) electric log <u>no</u> (yes or no)			
(organization running log)			
(8) how well bottom plugged <u>backwash</u>			
DRILLERS REMARKS:			

DEPT. OF NATURAL RESOURCES
 BUREAU OF LAND & WATER RESOURCES

AUG - 5 1982
RECEIVED

If well telescopes please sketch and show depths.

GROUND LEVEL

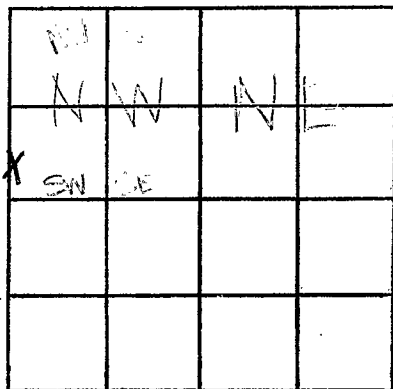

SECTION 24

Please indicate well location X.

ADDITIONAL INFORMATION

If more than one screen, show locations of each on sketch.