

MISSISSIPPI DEPARTMENT OF NATURAL RESOURCES

Bureau of Land and Water Resources

Southport Mall

P.O. Box 10631

Jackson, Mississippi 39209

WATER WELL DRILLERS LOG

WALTHALL
G 48 G
12/17/82

12/17/82 date well completed
 Jon Jeffrey Water Well firm name
 Walthall, MS county well located

LANDOWNER: Maxwell, Expl.	description of formations encountered	from	to
	Sand	0	40
	Shale	40	85
	Sand	85	400
(mailing address)			
WELL LOCATION:			
sec 26 T 20 N R 12 E			
2 miles N of DePue, Mo.			
WELL PURPOSE: Oil			
1125' S E 500' W of NE 1/4			
WELL COMPLETION DATA:			
(1) diameter (inches) 3"			
(2) total depth (feet) 400			
(3) static water level (feet) 40' below top of ground.			
(4) casing Steel, 360' (material), (depth)			
N/A if telescope see back.			
(5) screen 40', 360' (length), (depth to top)			
3" slot (size), (material)			
(6) pump none, 90 (HP), (yield gpm)			
air lift (type power)			
(7) electric log none (yes or no)			
N/A (organization running log)			
(8) how well bottom plugged welded			
DRILLERS REMARKS:			

CODED


DEPT. OF NATURAL RESOURCES
 OF LAND & WATER RESOURCES

FEB 22 1983

RECEIVED

If well telescopes please sketch and show depths.

GROUND LEVEL

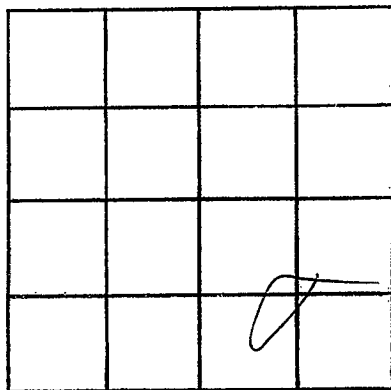

SECTION 26

Please indicate well location X.

ADDITIONAL INFORMATION

If more than one screen,
show locations of each on sketch.