

MISSISSIPPI DEPARTMENT OF NATURAL RESOURCES

Bureau of Land and Water Resources

Southport Mall

P.O. Box 10631

Jackson, Mississippi 39209

WATER WELL DRILLERS LOG

Walthall
G50

4-30-85 Griner Drilling Service, Inc. Walthall

date well completed

firm name

county well located


LANDOWNER:	description of formations encountered	from	to
Justiss Oil Company P.O. Box N Jena, La. 71342 (mailing address)			
WELL LOCATION: 1470' N + 2940' E sec. 34 T. 2 N R. 12 E SW 1/4 Org. C. Collins Associates, Inc. Dexter Field (distance in miles) (nearest town) No. 3 P.E. Mayce			
WELL PURPOSE: oil-field supply (home, irrigation, municipal, industrial)			
WELL COMPLETION DATA: (1) diameter (inches) 3" (2) total depth (feet) 315' (3) static water level (feet) 50' below top of ground. (4) casing steel 315' (material) (depth) 3" (size) if telescope see back. (5) screen 42' 273' (length) (depth to top) 3" perforated (size) (material) (6) pump 75-80 (HP) (yield gpm) AC (type power) (7) electric log (yes or no) (organization running log) (8) how well bottom plugged orange peel			
DRILLERS REMARKS:			

RECEIVED
MAY - 6 1985

Department of Natural Resources
Bureau of Land & Water Resources

If well telescopes please sketch and show depths.

GROUND LEVEL

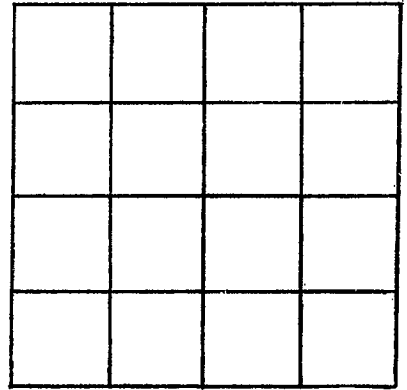

SECTION _____

Please indicate well location X.

ADDITIONAL INFORMATION

If more than one screen,
show locations of each on sketch.