

County: Walthall
 Permit #: 0-586
 Driller: JAMES WELLS
 Date drilling completed: 5-23-13

State Well Report
Part 1 - Driller's Log
 Mississippi Department of Environmental Quality
 Office of Land and Water Resources
 P.O. Box 2309
 Jackson, MS 39225
 (601)961- 5210
 (601)961- 5228 (fax)

For Office Use Only:
 Aquifer: _____
 Well #: 678
 L. S. Elevation: _____
 E-log #: _____

State Law requires that this report be prepared by the license holder responsible for the work and filed with the Department at the above address within 30 days of completion of drilling of the well or borehole.

| Information on Well Owner (Landowner if borehole is not for a water well) | Well or Borehole Location |
|--|--|
| Owner Name: <u>James E. Magee</u> | Latitude: <u>31° 06' 00" N</u> Longitude: <u>090° 20' 49" W</u> |
| Mailing Address: <u>640 Fordville Rd</u> | Method of Lat/Long (circle one): Conventional Survey, <input checked="" type="checkbox"/> USGS quad, <input type="checkbox"/> Hand-held GPS, <input type="checkbox"/> Survey-grade GPS |
| <u>Tylertown MS 39667</u> | NW 1/4 NE 1/4 Sec <u>31</u> Twn <u>2N</u> Rng <u>12E</u> |
| City: _____ State: _____ Zip Code: _____ | Distance _____ Miles Direction <u>E</u> of Nearest Town <u>Tylertown</u> |
| Telephone No. <u>(601) 876-2235</u> | |

Well / Borehole Data

Date drilling started: 5-23-13 Date drilling completed: 5-23-13 Hole depth: 200 Hole diameter: 2 1/2

Location of the source of any surface water used for drilling: Good City Water

Method of dosing and volume of Chlorine used in drilling and development: Shock

Logs run (circle all applicable): No log run Electric Gamma Ray Density Sonic Neutron Other: _____

Name of organization running log(s): _____

Purpose of borehole (check one): Water Well Geotechnical/Geological Investigation Ground Source Heat Pump Seismic Survey Other (describe) _____

If drilling is not related to water well construction, skip the remainder of this block

Purpose of Well (check one): Home Industrial Public Supply Irrigation Fish Culture Other: _____

If a flowing well, method of flow regulation: Valve _____ Other (describe) _____

Static Water Level: 80 feet above or below (circle one) land surface Date measured: 5-23-13

Method of Measurement (circle one) steel tape electric tape air line other: _____

Well depth: 200 Well grouted to a depth of 10 feet Type of grout (circle one): neat cement Bentonite Mix

Casing length: 180 feet Casing diameter: 4 inches Type of casing: PVC

Screen length: 20 feet Screen diameter: 4 inches Type of screen: PVC

Screen slot size: .008 inches Setting depth: From _____ feet to _____ feet

Type of completion (circle all applicable): Gravel packed Underreamed Telescoped Open hole Natural Development

Other (describe): _____

Top of lap pipe or reduction in casing: _____ feet. *If telescoped or more than one screen, describe on next page*


Form: OLWR-SWR-1A (04/08)

RECEIVED
 SEP 13 2013
 BY: OLWR

The sketch below only required for water wells

Description of formations encountered must be provided for all wells and boreholes, unless specifically exempted by regulations

If well telescopes, show depths on sketch.

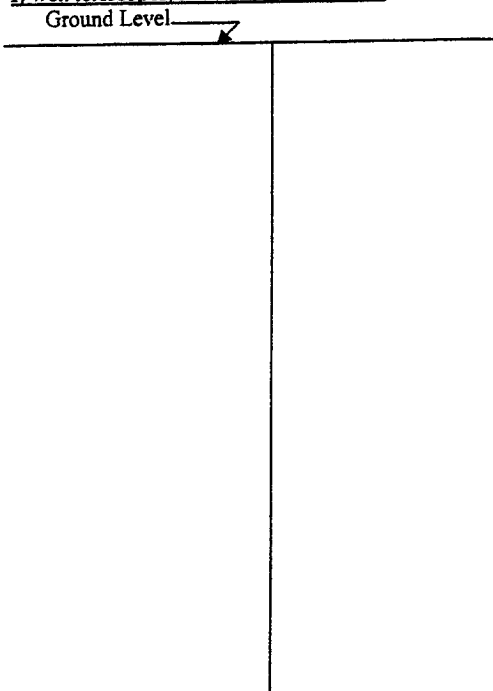

| Description of Formations Encountered | From (depth) | To (depth) |
|---------------------------------------|--------------|------------|
| TOP Soil | Ground Level | 1 |
| Clay | 25 | 25 |
| sand and Gravel | 25 | 200 |
| | | |
| | | |
If more than one screen, show location of each on sketch

Sketch the property layout and include the following: 1) the well location; 2) any permanent structures on the property that may aid in locating the well; 3) any roads, power lines, or other items that may aid in locating the property and the well; 4) a north arrow.

Landowner Name: James E Magee

Form: OLWR-SWR-1A (04/08)

I certify that the well/borehole was drilled, constructed, and completed in accordance with all applicable requirements of the Mississippi Department of Environmental Quality and the Mississippi Department of Health regulations, if applicable, and state laws.

JAMES WELLS 0-586
Print Name of Responsible Licensee and License No. _____ Date _____

James Wells RECEIVED
Signature of Licensee SEP 13 2013

BY: OLWR

STATE WELL REPORT

Part 2

Pump Installer's Completion Report
 Mississippi Department of Environmental Quality
 Office of Land and Water Resources
 P.O. Box 2309
 Jackson, MS 39225
 (601)961-5210
 (601)961-5228 (fax)

County: Walthall
 Permit #: _____
 Driller: JAMES WELLS
 Date completed: 5-23-13
Copy information from block on Part 1

For Office Use Only:

Aquifer: _____
 Well #: 678
 Elevation: _____

This part of the report must be completed by a licensed water well contractor or a licensed pump installer. A copy of Part 1 of the report must be attached and both parts filed with the Department at the above address within 30 days of well completion.

| Well Owner Information | Well Location |
|---------------------------------------|---|
| Owner Name: <u>James E. Magee</u> | Latitude: <u>N 31°06.060</u> Longitude: <u>N 090°00.823</u> |
| Mailing Address: <u>640 Knoxville</u> | Method of Lat/Long (check one): Conventional Survey _____ |
| <u>Tylertown, MS 39667</u> | USGS quad _____ Hand-held GPS _____ Survey-grade GPS _____ |
| City State Zip Code | <u>NW 1/4 NE 1/4 Sec 32 T2N R12E</u> |
| Telephone No. <u>(601) 876-2225</u> | Distance _____ Direction <u>32</u> Nearest Town _____ |
| | _____ Miles <u>E</u> of <u>Tylertown</u> |

| Pump Type Circle one | Power Type Circle one |
|---|---|
| Air Lift Jet <input type="radio"/> <u>Submersible</u> | Diesel Engine Gasoline Engine Natural Gas |
| Bucket Piston Turbine | <u>Electric Motor</u> Hand Tractor PTO |
| Centrifugal Rotary Flowing Well | Windmill Other (specify): _____ |
| Other (specify): _____ | Horse Power Rating of Motor: <u>1HP.</u> |
| Date Pump Installed: <u>5-23-13</u> | Setting Depth: <u>100</u> feet |
| Rated Pump Capacity: <u>15</u> Gallons Per Minute | Number of Stages: <u>11</u> |

| Pump Test Data | Method of Measuring Water Level Circle one |
|--|---|
| Date Well Tested: <u>5-23-13</u> | Air Line Electric Measuring Line <u>Steel Tape</u> |
| Static Water Level (A): <u>80</u> Feet Below Land Surface | Other (specify): _____ |
| Pumping Water Level (B): <u>85</u> Feet Below Land Surface | For flowing well, measured shut in head: _____ feet |
| Drawdown [(B) - (A)]: <u>85</u> Feet Below Land Surface | Well yielded <u>15</u> GPM with a drawdown of _____ |
| Test Pumping Rate: <u>15</u> Gallons Per Minute | <u>5</u> feet after <u>4</u> hours of pumping |
| Duration of Pump Test (minimum 4 hours): <u>4</u> hours | |

I HEREBY CERTIFY that the above statements are true to the best of my knowledge.

JAMES WELLS 0-586
 Print Name of Pump Installer and License No. (if applicable)

James Wells
 Signature of Pump Installer

RECEIVED

Form: OLWR-SWR-1B (04/08)

SEP 13 2013

BY: OLWR