

G 2001

# WATER WELL DRILLERS LOG

6

Date: 11-24, 1963, Driller: S S Rouse County Madison

(Name)

Ethan

(1) Owner of Land: Peber, Dastenkoy

(Name)

Zylbertown Miss.

(Address)

(2) Location: 1/4, 1/4, Sec. 17-2-12, T.     R.    

    miles 9, of    , of      
(distance) (direction) (Nearest Town)

(3) Topography:     (Hilly)     (Flat)     (Level)

(4) Purpose of Well: Farm  
(Domestic Irrigation  
Municipal, Industrial, Other)

Description & Color of Materials Sand, Clay, Red Clay, Shell, etc.	Thick- ness Feet	Depth Feet
<u>Red sand sand</u>		
<u>Red clay 80 feet</u>		
<u>20 fine sand</u>		
<u>30 Red Gravel</u>		

### Information upon completion of well:

(1) Diameter 4 inches.

(2) Total Depth 130 feet.

(3) Water Level 80 feet below top of ground.

(4) Cased to 125, Size 4


(5) Screen: Size 4, Length 5

(6) Were any formations sealed against pollution?  
    yes, X no.

If YES depth of formation    

Why    

Drillers Remarks:    

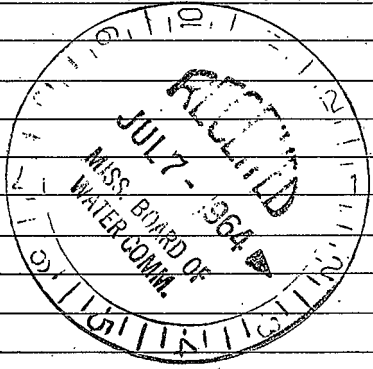

Well No.

(Use Back Side)

