

Walshall  
 G 2004  
 9/75

MISSISSIPPI  
 BOARD OF WATER COMMISSIONERS  
 416 North State Street  
 Jackson, Mississippi 39201

WATER WELL DRILLERS LOG

Sept. 25 E.B. Sheppard Walshall  
 date well completed firm name county well located

LANDOWNER:

Devan Magee  
 Rt. 2 - Iylertown  
 (mailing address)

description of formations encountered

from to

RED SANDY clay	0	90'
GR. STAKG. & clay	90	130'
SAND & PEA GR.	130	162'

WELL LOCATION:

sec. 17 T 2 N R 12 E 13V  
 7 miles E Iylertown  
 (distance) (direction) (nearest town)

WELL PURPOSE:

(home) Irrigation, municipal, industrial

WELL COMPLETION DATA:

- (1) diameter (inches) 2"
- (2) total depth (feet) 162'
- (3) static water level (feet) 120' below top of ground.
- (4) casing pl. 157' (material) (depth)  
 2" (size) If telescope see back.
- (5) screen 5' (length) (depth to top)  
 2" (size) pl. (material)
- (6) pump 1 1/2 (HP) 7 (yield gpm)  
 E (type power)
- (7) electric log (yes or no) (no)

(organization running log)

(8) how well bottom plugged BWV


DRILLERS REMARKS:

RECEIVED  
 MISSISSIPPI  
 DEC - 5 1975

MISS. BD. OF WATER COMMISSIONERS

If well telescopes please sketch and show depths.

GROUND LEVEL

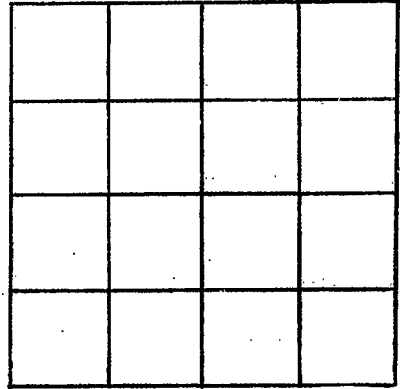

SECTION \_\_\_\_\_

Please indicate well location X.

ADDITIONAL INFORMATION

If more than one screen,  
show locations of each on sketch.