

WALTHALL
 G 2007
 3/18/77

MISSISSIPPI
 BOARD OF WATER COMMISSIONERS
 416 North State Street
 Jackson, Mississippi 39201

WATER WELL DRILLERS LOG

3-18

19

77 *Fitzgerald Well Serv*
 firm name

Walthall
 county well located

LANDOWNER:

Mary Stream

R.P. Lytleburg, Miss.
 (mailing address)

description of formations encountered

from

to

Red clay
Red gravel
Red sand

0 20
 20 90
 90 126
 126 140

WELL LOCATION:

sec. 5 T. 2 N S R. 10E E
12 if 9m
9 miles E of *Fykeburg*
 (distance) (direction) (nearest town)

Coarse sand & gravel

WELL PURPOSE:

(home, irrigation, municipal, industrial)

WELL COMPLETION DATA:

- (1) diameter (inches) 4
- (2) total depth (feet) 140
- (3) static water level (feet) 110 below above top of ground.
- (4) casing PVC, 132
 (material) (depth)
4 if telescope see back.
 (size)
- (5) screen 8, 132
 (length) (depth to top)
4 (size) PVC (material)
- (6) pump 1/2, 10
 (HP) (yield gpm)
du (type power)
- (7) electric log no
 (yes or no)
 (organization running log)
- (8) how well bottom plugged *Small bit*


DRILLERS REMARKS:

RECEIVED
 MAR 30 1977

MISS. BD. OF WATER COMM.

If well telescopes please sketch and show depths.

GROUND LEVEL

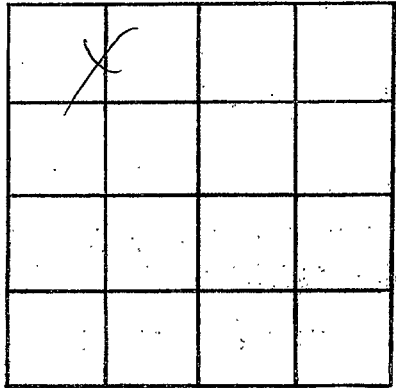

SECTION 5

Please indicate well location X.

ADDITIONAL INFORMATION

If more than one screen,
show locations of each on sketch.