

WALTHALL  
 G 2008  
 12-15-77

MISSISSIPPI  
 BOARD OF WATER COMMISSIONERS  
 416 North State Street  
 Jackson, Mississippi 39201

WATER WELL DRILLERS LOG

Dec 15 1977 Recesswell Inc Walthall  
 date well completed firm name county well located

LANDOWNER:  
William (Bill) Hampton  
Pt 2 - box 229 - Tylotown  
 (mailing address)

description of formations encountered	from	to
<u>Red clay</u>	<u>0</u>	<u>12</u>
<u>Red sand</u>	<u>12</u>	<u>80</u>
<u>Coarse sand &amp; gravel</u>	<u>80</u>	<u>90</u>

WELL LOCATION:  
 sec 32 T 2 N R 12 E  
2 miles south of Repton  
 (distance) (direction) (nearest town)

WELL PURPOSE: Farm  
 (home, irrigation, municipal, industrial)

- WELL COMPLETION DATA:
- (1) diameter (inches) 4"
  - (2) total depth (feet) 90
  - (3) static water level (feet) 70 below above top of ground.
  - (4) casing plastic, bottom  
 (material) (depth)  
 \_\_\_\_\_ if telescope see back.  
 (size)
  - (5) screen 6', 84  
 (length) (depth to top)  
4", plastic  
 (size) (material)
  - (6) pump none installed  
 (HP) (yield gpm)  
elect  
 (type power)
  - (7) electric log no  
 (yes or no)  
 \_\_\_\_\_  
 (organization running log)

(8) how well bottom plugged  
Woods plug  
 DRILLERS REMARKS


RECEIVED

FEB - 7 1977

MISS. BD. OF WATER COMMISSIONERS

If well telescopes please sketch and show depths.

GROUND LEVEL

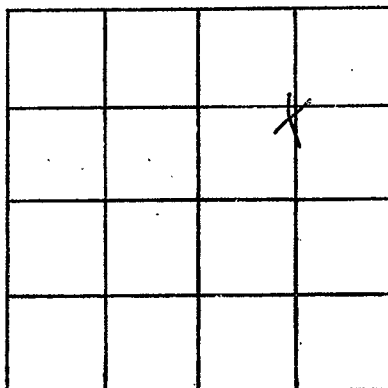

SECTION 32

Please indicate well location X.

ADDITIONAL INFORMATION

If more than one screen,  
show locations of each on sketch.