

WALTHALL
 G 208A
 6-11-77

MISSISSIPPI
 BOARD OF WATER COMMISSIONERS
 416 North State Street
 13V Jackson, Mississippi 39201

64

WATER WELL DRILLERS LOG

June 11, 1977 Beaver Well Driller Walthall
 date well completed firm name county well located

LANDOWNER:
Sam Popwell
Rt 2 Tipton
 (mailing address)

description of formations encountered	from	to
Red Clay	0	17
Red sand	17	55
Sand & Gravel	55	60
Rocky sand	60	105
fine gravel & sand	105	120

WELL LOCATION:
 sec. 30 T. 2 N R. 12 E
6 miles East of Tipton
 (distance) (direction) (nearest town)

WELL PURPOSE: Home
 (home, irrigation, municipal, industrial)


WELL COMPLETION DATA:
 (1) diameter (inches) 4 1/2"
 (2) total depth (feet) 120
 (3) static water level (feet) 40 below top of ground.
 (4) casing Plastic (material) Grout (depth)
 (size) if telescope see back.
 (5) screen 6" (length) 114 (depth to top)
4" (size) Plastic (material)
 (6) pump 1/2 (HP) 10 (yield gpm)
elect (type power)
 (7) electric log no (yes or no)
 (organization running log)

(8) how well bottom plugged plug
 DRILLERS REMARKS:

RECEIVED
 JUN 21 377
 MISS. BD. OF WATER COMMISSIONERS

If well telescopes please sketch and show depths.

GROUND LEVEL

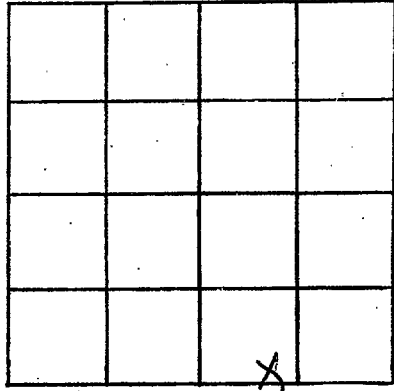

SECTION 30

Please indicate well location X.

ADDITIONAL INFORMATION

If more than one screen, show locations of each on sketch.