

WALTHALL

G 2010

8-10-77

MISSISSIPPI BOARD OF WATER COMMISSIONERS

416 North State Street

13V Jackson, Mississippi 39201

WATER WELL DRILLERS LOG

8-10 date well completed

1977 Federal Well Serv firm name

Walthall county well located

LANDOWNER:	description of formations encountered	from	to
<i>Doris Rushing</i>	<i>Red clay</i>	0	20
<i>P.R. Lybster</i> (mailing address)	<i>Red sand</i>	20	60
WELL LOCATION:	<i>white chalk</i>	60	230
sec. <u>6</u> T. <u>20</u> N. S. R. <u>12</u> E. W.	<i>Coarse sand & gravel</i>	230	248
6 miles E of <i>Tylerton</i> (distance) (direction) (nearest town)			
WELL PURPOSE: <i>Home</i> (home, irrigation, municipal, industrial)			
WELL COMPLETION DATA:			
(1) diameter (inches) <u>4</u>			
(2) total depth (feet) <u>248</u>			
(3) static water level (feet) <u>135</u> below top of ground.			
(4) casing <u>PVC</u> <u>240</u> (material) (depth)			
<u>4</u> if telescope see back. (size)			
(5) screen <u>8</u> <u>240</u> (length) (depth to top)			
<u>4</u> <u>PVC</u> (size) (material)			
(6) pump <u>1/2</u> <u>10</u> (HP) (yield gpm)			
<u>elec</u> (type power)			
(7) electric log <u>no</u> (yes or no)			
(organization running log)			
(8) how well bottom plugged <u>land hard</u>			
DRILLERS REMARKS:			


RECEIVED

AUG 29 1977

MISS. RD. OF WATER COMMISSIONERS

If well telescopes please sketch and show depths.

GROUND LEVEL

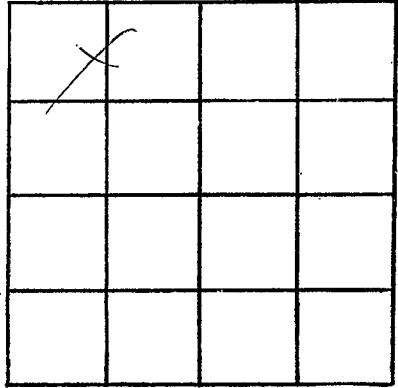

SECTION 6

Please indicate well location X.

ADDITIONAL INFORMATION

If more than one screen,
show locations of each on sketch.