

WALTHALL

G 2011

3-10-78

MISSISSIPPI BOARD OF WATER COMMISSIONERS 416 North State Street Jackson, Mississippi 39201

WATER WELL DRILLERS LOG

3-10

date well completed

78 Fitzgerald & Co

firm name

Walthall

county well located

LANDOWNER:

Martino F. Magee

R.R. 146 (mailing address)

description of formations encountered

from

to

Red Clay 0 20
Red Sand 20 160
Coarse sand & gravel 160 170

WELL LOCATION:

sec. 18 T. 12 N. R. 12 E S. W.

2 miles E of KNOX (distance) (direction) (nearest town)

WELL PURPOSE: Home (home, irrigation, municipal, industrial)

WELL COMPLETION DATA:

- (1) diameter (inches) 4
(2) total depth (feet) 170
(3) static water level (feet) 120 below top of ground.
(4) casing PVC, 162 (material) (depth) 4 (size) if telescope see back.
(5) screen 8, 162 (length) (depth to top) 4 (size) PVC (material)
(6) pump 1/2 (HP) 10 (yield gpm) Elec (type power)
(7) electric log no (yes or no)
(organization running log)
(8) how well bottom plugged Seal block


RECEIVED

APR 27 1978

DRILLERS REMARKS:

If well telescopes please sketch and show depths.

GROUND LEVEL

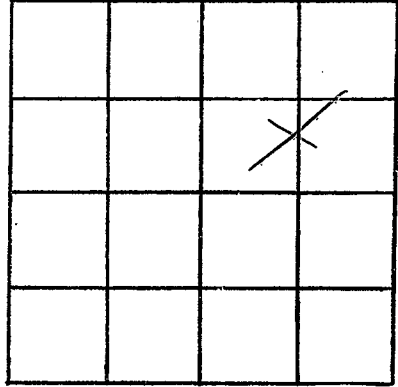

SECTION 18

Please indicate well location X.

ADDITIONAL INFORMATION

If more than one screen,
show locations of each on sketch.