

WALTHALL
 G 2012
 3-17-78

MISSISSIPPI
 BOARD OF WATER COMMISSIONERS
 416 North State Street
 Jackson, Mississippi 39201

WATER WELL DRILLERS LOG

3-17-78 date well completed Filson & Sons firm name Walthall county well located

LANDOWNER:
 Logan Jones
 R.R. 1 (mailing address)

description of formations encountered	from to	
	ft	ft
Red clay	0	20
Red sand	20	130
Coarse sand & gravel	130	155

WELL LOCATION:
 sec. 18 T. 22 N. R. 12 E
 2.7 miles E of GLO (distance) (direction) (nearest town)

WELL PURPOSE: (home, irrigation, municipal, industrial)

WELL COMPLETION DATA:

(1) diameter (inches) 4

(2) total depth (feet) 155

(3) static water level (feet) 135 below top of ground.

(4) casing (material) PVC (depth) 147
 4 (size) if telescope see back.

(5) screen (length) 8 (depth to top) 147
 4 (size) PVC (material)

(6) pump (HP) 1/2 (yield, gpm) 10
 elec (type power)

(7) electric log (yes or no) No

(organization running log)

(8) how well bottom plugged Sand & gravel


DRILLERS REMARKS:

RECEIVED

APR 27 1978

If well telescopes please sketch and show depths.

GROUND LEVEL

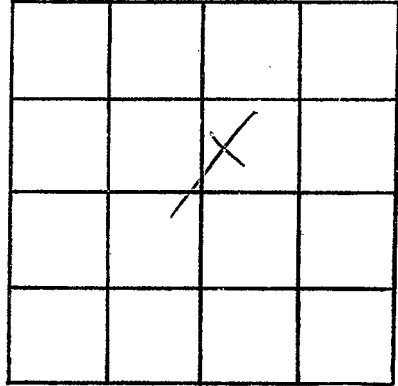

SECTION 18

Please indicate well location X.

ADDITIONAL INFORMATION

If more than one screen,
show locations of each on sketch.