

MISSISSIPPI DEPARTMENT OF NATURAL RESOURCES

Bureau of Land and Water Resources

Southport Mall

P.O. Box 10631

Jackson, Mississippi 39209

WATER WELL DRILLERS LOG

Walthall
G 2013
3/13/81
3/13
 date well completed

Dunaway's Plumbing
 firm name

WALTHALL
 county well located

LANDOWNER: Butford Pigott
Route 2 Box 169
Tylertown, Ms
 (mailing address)

description of formations encountered	from	to
	<u>Top soil</u>	<u>0</u>
<u>SAND</u>	<u>5</u>	<u>12</u>
<u>CLAY</u>	<u>12</u>	<u>47</u>
<u>SAND</u>	<u>47</u>	<u>60</u>

WELL LOCATION:
 sec 33 T 2 N R 13 E
1 1/2 miles N of Dexter
 (distance) (direction) (nearest town)

WELL PURPOSE:
 (home) irrigation, municipal, industrial

WELL COMPLETION DATA:

(1) diameter (inches) 4 inch

(2) total depth (feet) 60 ft

(3) static water level (feet) 8 ft below top of ground.

(4) casing PVC 60 ft
 (material) (depth)

_____ if telescope see back.
 (size)

(5) screen 10 ft 50 ft
 (length) (depth to top)

H PVC
 (size) (material)

(6) pump NONE - SET ON
 (HP) (yield gpm)


_____ (type power)

(7) electric log NO
 (yes or no)

_____ (organization running log)


(8) how well bottom plugged SAND SHARK

DRILLERS REMARKS:

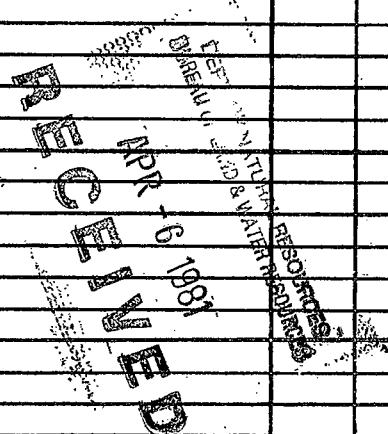

If well telescopes please sketch and show depths.

GROUND LEVEL

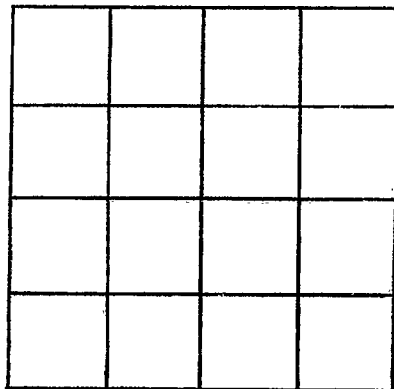

SECTION _____

Please indicate well location X.

ADDITIONAL INFORMATION

If more than one screen,
show locations of each on sketch.