

WALTHALL
 G 2014
 4-21-81

MISSISSIPPI
 BOARD OF WATER COMMISSIONERS
 416 North State Street
 Jackson, Mississippi 39201

WATER WELL DRILLERS LOG

4-21-81 date well completed 1981 firm name *Small well* county well located *Walthall*

LANDOWNER:

Rowell Moyer

R.B. Kurto
 (mailing address)

WELL LOCATION:

sec. 2 T. 2 N R. 12 E
 S W
1 miles NE of Kurto
 (distance) (direction) (nearest town)

WELL PURPOSE: Home
 (home, irrigation, municipal, industrial)

WELL COMPLETION DATA:

- (1) diameter (inches) 4
- (2) total depth (feet) 172
- (3) static water level (feet) 130 below above top of ground.
- (4) casing PVC, 164,
 (material) (depth)
4 If telescope see back.
 (size)
- (5) screen 8, 164
 (length) (depth to top)
4, PVC
 (size) (material)
- (6) pump 3/4 15
 (HP) (yield gpm)
4hp
 (type power)
- (7) electric log yes
 (yes or no)
 (organization running log)
- (8) how well bottom plugged Sealed

description of formations encountered

from to

<i>Red clay</i>	<i>0</i>	<i>20</i>
<i>Red bent</i>	<i>20</i>	<i>100</i>
<i>white clay</i>	<i>100</i>	<i>160</i>
<i>Concrete sand & gravel</i>	<i>160</i>	<i>172</i>


DRILLERS REMARKS:

DEPT. OF NATURAL RESOURCES
 BUREAU OF LAND & WATER RESOURCES

APR 29 1981
 RECEIVED

If well telescopes please sketch and show depths.

GROUND LEVEL

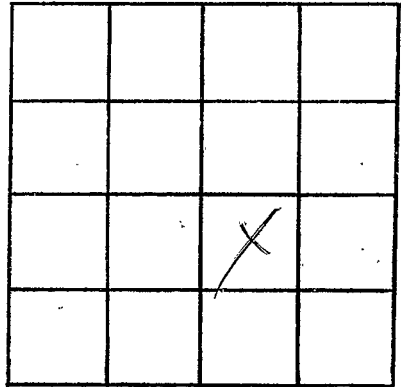

SECTION 2

Please indicate well location X.

ADDITIONAL INFORMATION

If more than one screen,
show locations of each on sketch.