

MISSISSIPPI DEPARTMENT OF NATURAL RESOURCES

Bureau of Land and Water Resources

Southport Mall

P.O. Box 10631

Jackson, Mississippi 39209

WATER WELL DRILLERS LOG

Walthell
66
2015

2-9 1984
 date well completed

H. Swallwell Inc
 firm name

Walthell
 county well located

LANDOWNER:	description of formations encountered	from	to
<u>J.C. Barrett</u>	<u>Red clay</u>	<u>0</u>	<u>20</u>
<u>R.R. Leland</u> (mailing address)	<u>Red sand</u>	<u>20</u>	<u>155</u>
	<u>Green silt & gravel</u>	<u>155</u>	<u>170</u>

WELL LOCATION:
 sec. 19 T-2 N R-12 E
 S W
2 miles E of Glad
 (distance) (direction) (nearest town)

WELL PURPOSE: Home
 (home, irrigation, municipal, industrial)


- WELL COMPLETION DATA:
- (1) diameter (inches) 4
 - (2) total depth (feet) 170 170
 - (3) static water level (feet) 108 below above top of ground.
 - (4) casing PVC, 162,
 (material) (depth)
4 if telescope see back.
 (size)
 - (5) screen 8, 162
 (length) (depth to top)
4, PVC
 (size) (material)
 - (6) pump 3/4, 15
 (HP) (yield gpm)
Electric
 (type power)
 - (7) electric log No
 (yes or no)
 (organization running log)
 - (8) how well bottom plugged Sealed

DRILLERS REMARKS:

DEPT. OF NATURAL RESOURCES
 BUREAU OF LAND & WATER RESOURCES
 MAR - 8 1984
 RECEIVED

If well telescopes please sketch and show depths.

GROUND LEVEL

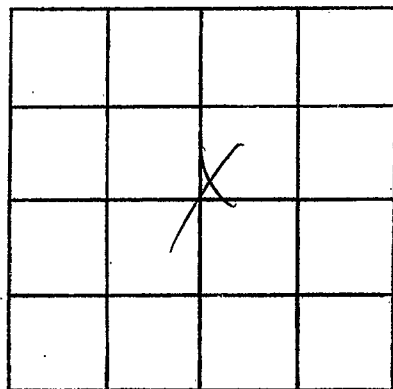

SECTION 19

Please indicate well location X.

ADDITIONAL INFORMATION

If more than one screen,
show locations of each on sketch.