

WALTHALL
CR 2017

MISSISSIPPI DEPARTMENT OF NATURAL RESOURCES
Bureau of Land and Water Resources
Southport Mall
P.O. Box 10631
Jackson, Mississippi 39209
WATER WELL DRILLERS LOG

11-20 1985 Fitzgerald Well Serv Walthall
date well completed firm name county well located

LANDOWNER:
Willie Whittington
R.R. Felton, Jr.
(mailing address)

description of formations encountered	from	to
<u>Red clay</u>	<u>0</u>	<u>20</u>
<u>Red sand</u>	<u>20</u>	<u>105</u>
<u>Concrete sand & gravel</u>	<u>105</u>	<u>127</u>

WELL LOCATION:
sec. 31 T 2 N R 12 E
S W
8 miles SE of Tylertown
(distance) (direction) (nearest town)

WELL PURPOSE: Home
(home, irrigation, municipal, industrial)

- WELL COMPLETION DATA:
- (1) diameter (inches) 4
 - (2) total depth (feet) 127
 - (3) static water level (feet) 100 below above top of ground.
 - (4) casing PVC, 117,
(material) (depth)
4 if telescope see back.
(size)
 - (5) screen 10, 117
(length) (depth to top)
4, PVC
(size) (material)
 - (6) pump 3/4, 15
(HP) (yield gpm)
elc
(type power)
 - (7) electric log no
(yes or no)
(organization running log)
 - (8) how well bottom plugged Seal bit

RECEIVED


NOV 27 1985

DRILLERS REMARKS:

Department of Natural Resources
Bureau of Land & Water Resources

If well telescopes please
sketch and show depths.

GROUND LEVEL

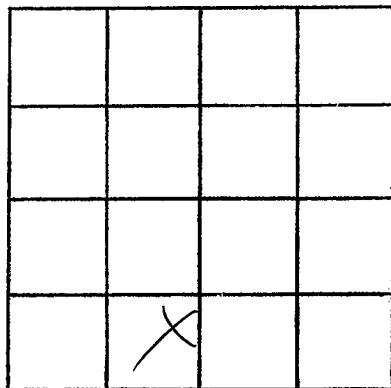

SECTION 31

Please indicate well location X.

ADDITIONAL INFORMATION

If more than one screen,
show locations of each on sketch.