

MISSISSIPPI DEPARTMENT OF NATURAL RESOURCES

Bureau of Land and Water Resources

Southport Mall

P.O. Box 10631


Jackson, Mississippi 39209

WATER WELL DRILLERS LOG

WALTHAM  
G 2019

6-19 1986 Fitzgerald Well Serv Waltham  
date well completed firm name county well located

LANDOWNER:	description of formations encountered	from	to
<u>Johnny Conner</u> <u>P.R. Fishburn, ms.</u> (mailing address)	<u>Red clay</u> <u>Red sand</u> <u>Coarse sand &amp; gravel</u>	<u>0</u> <u>20</u> <u>185</u>	<u>26</u> <u>185</u> <u>200</u>
<b>WELL LOCATION:</b>			
sec. <u>17</u> T. <u>2</u> N R. <u>12</u> E S W <u>6</u> miles <u>E</u> of <u>Fishburn</u> (distance) (direction) (nearest town)			
<b>WELL PURPOSE:</b> <u>Home</u> (home, irrigation, municipal, industrial)			
<b>WELL COMPLETION DATA:</b>			
(1) diameter (inches) <u>4</u>			
(2) total depth (feet) <u>200</u>			
(3) static water level (feet) <u>100</u> below above top of ground.			
(4) casing <u>POC</u> , <u>190</u> (material) (depth) <u>4</u> if telescope see back. (size)			
(5) screen <u>10</u> , <u>190</u> (length) (depth to top) <u>4</u> , <u>POC</u> (size) (material)			
(6) pump <u>1/2</u> , <u>10</u> (HP) (yield gpm) <u>elec</u> (type power)			
(7) electric log <u>no</u> (yes or no) <u>no</u> (organization running log)			
(8) how well bottom plugged <u>Seal ok</u>			

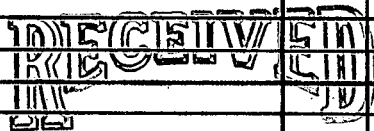


JUL 21 1986

Department of Natural Resources  
Bureau of Land & Water Resources

DRILLERS REMARKS:

If well telescopes please sketch and show depths.

GROUND LEVEL

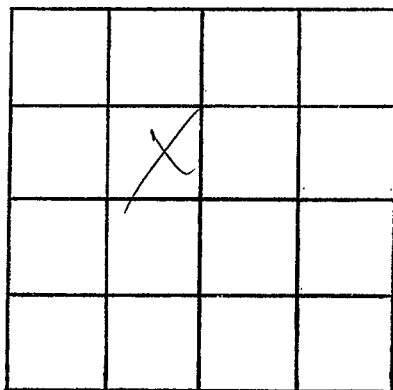

SECTION 17

Please indicate well location X.

ADDITIONAL INFORMATION

If more than one screen,  
show locations of each on sketch.