

WALTHAM
G 2020

MISSISSIPPI DEPARTMENT OF NATURAL RESOURCES
 Bureau of Land and Water Resources
 Southport Mall
 P.O. Box 10631
 Jackson, Mississippi 39209
WATER WELL DRILLERS LOG

July 31 1987 F. G. Well Well Serv. Motion
 date well completed firm name county well located

LANDOWNER:	description of formations encountered	from	to
<u>Matthew Foxworth</u> <u>R.R. Tylburn, Inc.</u> (mailing address)			
WELL LOCATION:			
sec. <u>5</u> T <u>2</u> N R <u>12</u> E S W			
<u>8</u> miles <u>E</u> of <u>Tylburn</u> (distance) (direction) (nearest town)			
WELL PURPOSE: <u>Home</u> (home, irrigation, municipal, industrial)			
WELL COMPLETION DATA:			
(1) diameter (inches) <u>4</u>			
(2) total depth (feet) <u>156</u>			
(3) static water level (feet) <u>100</u> below above top of ground.			
(4) casing <u>pc</u> <u>146</u> (material) (depth) <u>4</u> if telescope see back. (size)			
(5) screen <u>10</u> <u>146</u> (length) (depth to top) <u>4</u> <u>pc</u> (size) (material)			
(6) pump <u>3/4</u> <u>10</u> (HP) (yield gpm) <u>elec</u> (type power)			
(7) electric log <u>No</u> (yes or no) (organization running log)			
(8) how well bottom plugged <u>Seal plug</u>			
DRILLERS REMARKS:			


RECEIVED

AUG 27 1987

Department of Natural Resources
 Bureau of Land & Water Resources

If well telescopes please sketch and show depths.

GROUND LEVEL

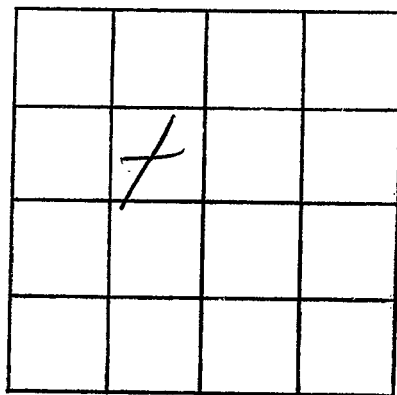

SECTION 5

Please indicate well location X.

ADDITIONAL INFORMATION

If more than one screen,
show locations of each on sketch.