

MISSISSIPPI DEPARTMENT OF NATURAL RESOURCES

Bureau of Land and Water Resources

Southport Mall

P.O. Box 10631

Jackson, Mississippi 39209

WATER WELL DRILLERS LOG

WALTER
G
2004

6-12 1990 Paul Miller Walthall  
 date well completed firm name county well located


LANDOWNER:	description of formations encountered	from	to
<p>J.C. Cowart                      RR. Kahono ms.                      (mailing address)</p>	<p>beddy                      Red sand                      coarse sand &amp; gravel</p>	<p>0                      20                      131</p>	<p>20                      131                      145</p>
<p>WELL LOCATION:                      sec. <u>17</u> T. <u>2</u> N R. <u>12</u> E                      S W  <u>3</u> miles <u>ESE</u> of <u>Karbo</u>                      (distance) (direction) (nearest town)</p>			
<p>WELL PURPOSE: <u>Home</u>                      (home, irrigation, municipal, industrial)</p>			
<p>WELL COMPLETION DATA:</p> <p>(1) diameter (inches) <u>4</u></p> <p>(2) total depth (feet) <u>145</u></p> <p>(3) static water level (feet) <u>90</u> below above top of ground.</p> <p>(4) casing <u>PVC</u>, <u>135</u>                      (material) (depth)  <u>4</u> if telescope see back.                      (size)</p> <p>(5) screen <u>10</u>, <u>135</u>                      (length) (depth to top)  <u>4</u>, <u>PVC</u>                      (size) (material)</p> <p>(6) pump <u>1/2</u>, <u>10</u>                      (HP) (yield gpm)  <u>Elm</u>                      (type power)</p> <p>(7) electric log <u>no</u>                      (yes or no)                      (organization running log)</p> <p>(8) how well bottom plugged <u>Sealed</u></p>			
<p>DRILLERS REMARKS:</p>			

RECEIVED  
 JUN 28 1990

Department of Natural Resources  
 Bureau of Land & Water Resources

If well telescopes please sketch and show depths.

GROUND LEVEL

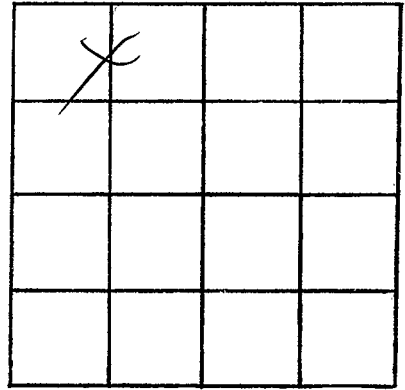

SECTION 12

Please indicate well location X.

ADDITIONAL INFORMATION

If more than one screen,  
show locations of each on sketch.