

**MISSISSIPPI DEPARTMENT OF ENVIRONMENTAL QUALITY**

Office of Land and Water Resources

P. O. Box 10631  
Jackson, MS 39289-0631  
**WATER WELL DRILLERS LOG**

COUNTY WELL LOCATED <i>Walton</i>	
WELL NUMBER <i>2031</i>	CODED
DATE WELL COMPLETED <i>1-13-97</i>	

PERMIT NUMBER
NAME OF DRILLING FIRM <i>Fitzgerald Well Service</i>

NAME & MAILING ADDRESS OF LANDOWNER <i>Albert Magee</i> <i>RR Tybertown</i>			
WELL LOCATION:	SEC <i>32</i>	TOWNSHIP <i>2</i>	RANGE <i>N 12 E</i> <i>S 12 W</i>
DISTANCE <i>8</i> Miles	DIRECTION <i>SE</i>	NEAREST TOWN <i>Tybertown</i>	
OTHER LANDMARK			
WELL PURPOSE: <input checked="" type="checkbox"/> Home Irrigation, <input type="checkbox"/> Municipal, <input type="checkbox"/> Industrial, <input type="checkbox"/> Fish Pond, etc.			

PUMP DATA			
PUMP TYPE (Circle One): <input checked="" type="radio"/> Submersible Turbine, <input type="radio"/> Jet <input type="radio"/> Flowing Well, Other (Describe) _____			
POWER TYPE (Circle One): <input checked="" type="radio"/> Electric, <input type="radio"/> Tractor, <input type="radio"/> Diesel, <input type="radio"/> Gasoline, <input type="radio"/> Butane, Other (Describe) _____ H/P <i>1</i>			
Pump Capacity (GPM) <i>20</i>	No. of Stages <i>10</i>	Setting Depth <i>110'</i>	FT.
PUMP TEST			
Well yielded <i>30</i> GPM with a drawdown of <i>1</i> ft. after <i>1</i> hours of pumping			

WELL DATA		
Well Depth <i>145'</i>	Casing Diameter (in.) <i>4"</i>	Casing Length (Ft.) <i>125'</i>
Type of Casing <i>PVC</i>	Hole Depth <i>145'</i>	Depth to Static Water Level <i>76'</i>
TYPE OF COMPLETION: (Circle One or More): <input checked="" type="checkbox"/> Gravel Pack, <input type="checkbox"/> Underreamed, <input type="checkbox"/> Telescoped, <input type="checkbox"/> Natural Development, <input type="checkbox"/> Open Hole, <input type="checkbox"/> Other (Describe) _____		
WELL GROUTED TO A DEPTH OF <i>10</i> FEET Type Grout (circle one): Cement, Bentonite, or <input checked="" type="radio"/> Mix		

LOG DATA	
TYPE OF LOG RUN (Circle One): <input checked="" type="radio"/> No Log Run, <input type="radio"/> Electric, <input type="radio"/> Gamma Ray, <input type="radio"/> Density, <input type="radio"/> Sonic, <input type="radio"/> Neutron, Other (Describe) _____	
Name of Organization Running Log	

SCREEN DATA		
Diameter - Inches <i>4 1/2"</i>	Length - Feet <i>20'</i>	Slot Size - Inches <i>010/012</i>
Screen Type <i>PVC</i>	Depth to Bottom - Feet <i>145'</i>	


GEOLOGIC DATA (Office Use Only)			
Surface Elev.	Geologic Unit	Unit Thickness	Depth to Top
Subs. SWL	Date	Analysis	Aquifer Test
Driller's Remarks			
Top of Lap Pipe or Reduction in Casing			
FEET	IF TELESCOPED OR MORE THAN ONE SCREEN: USE BACK PAGE		

DESCRIPTION OF FORMATIONS ENCOUNTERED	FROM	TO
<i>Top soil</i>	<i>0</i>	<i>5</i>
<i>red clay</i>	<i>5</i>	<i>30</i>
<i>Fine sand &amp; gravel</i>	<i>30</i>	<i>80</i>
<i>clay</i>	<i>80</i>	<i>100</i>
<i>Fine sand</i>	<i>100</i>	<i>120</i>
<i>course sand</i>	<i>120</i>	<i>145</i>

FORMATIONS ENCOUNTERED		FROM	TO
<b>RECEIVED</b>			
<b>MAY 14 1997</b>			
Dept. of Environmental Quality Office of Land & Water Resources			
IF MORE SPACE IS NEEDED, USE BACK			

If well telescopes please  
sketch and show depths.

GROUND LEVEL

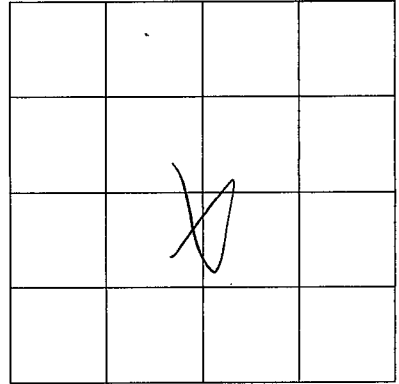

SECTION \_\_\_\_\_

Please indicate well location X.

ADDITIONAL INFORMATION

If more than one screen,  
show location of each on sketch.