

WALTHALL

MISSISSIPPI DEPARTMENT OF ENVIRONMENTAL QUALITY

Office of Land and Water Resources

P. O. Box 10631  
Jackson, MS 39289-0631  
WATER WELL DRILLERS LOG

COUNTY WELL LOCATED	
Region	
WELL NUMBER	CODED
G 2033	
DATE WELL COMPLETED	
9-10-97	

PERMIT NUMBER
NAME OF DRILLING FIRM
Fitzgerald well

NAME & MAILING ADDRESS OF LANDOWNER					
May Foxworth					
RR Kokomo					
WELL LOCATION: SEC TOWNSHIP RANGE					
8 2 N 12 E W					
DISTANCE		DIRECTION		NEAREST TOWN	
3 Miles		SW		of Kokomo	
OTHER LANDMARK					
WELL PURPOSE: <input checked="" type="checkbox"/> Home Irrigation, <input type="checkbox"/> Municipal, <input type="checkbox"/> Industrial, <input type="checkbox"/> Fish Pond, etc.					

PUMP DATA		
PUMP TYPE (Circle One):		
<input checked="" type="checkbox"/> Submersible, <input type="checkbox"/> Turbine, <input type="checkbox"/> Jet <input type="checkbox"/> Flowing Well,		
Other (Describe) _____		
POWER TYPE (Circle One):		
<input checked="" type="checkbox"/> Electric, <input type="checkbox"/> Tractor, <input type="checkbox"/> Diesel, <input type="checkbox"/> Gasoline, <input type="checkbox"/> Butane,		
Other (Describe) _____ H/P 3/4		
Pump Capacity (GPM)	No. of Stages	Setting Depth
12	12	130 FT.
PUMP TEST		
Well yielded 50 GPM with		
a drawdown of 1 ft.		
after 1 hours of pumping		

WELL DATA		
Well Depth	Casing Diameter (In.)	Casing Length (Ft.)
156'	4"	146'
Type of Casing	Hole Depth	Depth to Static Water Level
PVC	156'	94'

LOG DATA	
TYPE OF LOG RUN (Circle One):	
<input checked="" type="checkbox"/> No Log Run, <input type="checkbox"/> Electric, <input type="checkbox"/> Gamma Ray, <input type="checkbox"/> Density, <input type="checkbox"/> Sonic, <input type="checkbox"/> Neutron,	
Other (Describe) _____	
Name of Organization Running Log	

TYPE OF COMPLETION: (Circle One or More):

Gravel Packed,  Underreamed,  Telescoped,

Natural Development,  Open Hole,  Other

(Describe) \_\_\_\_\_

GEOLOGIC DATA (Office Use Only)			
Surface Elev.	Geologic Unit	Unit Thickness	Depth to Top
Subs. SWL	Date	Analysis	Aquifer Test

WELL GROUTED TO A DEPTH OF 10 FEET

Type Grout (circle one): Cement, Bentonite, or  Mix


SCREEN DATA		
Diameter - Inches	Length - Feet	Slot Size - Inches
4"	10	.010
Screen Type	Depth to Bottom - Feet	
PVC	156'	
Driller's Remarks		
Top of Lap Pipe or Reduction in Casing		
FEET IF TELESCOPED OR MORE THAN ONE SCREEN: USE BACK PAGE		

DESCRIPTION OF FORMATIONS ENCOUNTERED	FROM	TO
Top Soil	0	5
Red clay	5	60
Sand & gravel	60	100
Fine sand	100	140
Coarse sand	140	156

FORMATIONS (Continued)	FROM	TO
<b>RECEIVED</b>		
<b>OCT 06 1997</b>		
Dept. of Environmental Quality Office of Land & Water Resources		
IF MORE SPACE IS NEEDED, USE BACK		

If well telescopes please  
sketch and show depths.

GROUND LEVEL

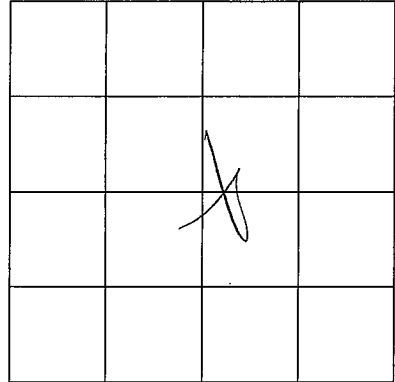

SECTION \_\_\_\_\_

Please indicate well location X.

ADDITIONAL INFORMATION

If more than one screen,  
show location of each on sketch.