

MISSISSIPPI DEPARTMENT OF ENVIRONMENTAL QUALITY

Office of Land and Water Resources

P. O. Box 10631
Jackson, MS 39289-0631
WATER WELL DRILLERS LOG

COUNTY WELL LOCATED <u>Walthall</u>	
WELL NUMBER <u>G-2035</u>	CODED
DATE WELL COMPLETED <u>3-11-00</u>	

PERMIT NUMBER <u>0-621</u>
NAME OF DRILLING FIRM <u>Daniel Boone</u>

NAME & MAILING ADDRESS OF LANDOWNER <u>Jerry Taylor</u>			
<u>Rosawelt, Magee Rd</u>			
<u>Tylertown, Ms.</u>			
WELL LOCATION	SEC	TOWNSHIP	RANGE
	<u>6</u>	<u>2</u> ^N	<u>12</u> ^E
DISTANCE	DIRECTION	NEAREST TOWN	
<u>8</u> Miles	<u>NE</u>	of <u>Tylertown</u>	
OTHER LANDMARK			
WELL PURPOSE: Home, <u>Irrigation</u> , Municipal, Industrial, Fish Pond, etc.			

PUMP DATA		
PUMP TYPE (Circle One): <u>Submersible</u> , Turbine, Jet, Flowing Well, Other (Describe) _____		
POWER TYPE (Circle One): <u>Electric</u> , Tractor, Diesel, Gasoline, Butane, Other (Describe) _____ H/P <u>5</u>		
Pump Capacity (GPM) <u>50</u>	No. of Stages	Setting Depth <u>250</u> FT.
PUMP TEST		
Well yielded <u>75</u> GPM with a drawdown of <u>100</u> ft. after <u>28</u> hours of pumping		

WELL DATA		
Well Depth <u>300'</u>	Casing Diameter (In) <u>4"</u>	Casing Length (Ft.) <u>260'</u>
Type of Casing: <u>PVC</u>	Hole Depth <u>300'</u>	Depth to Static Water Level <u>110'</u>

LOG DATA	
TYPE OF LOG RUN (Circle One): Electric, Gamma Ray, Density, Sonic, Neutron, Other (Describe) _____ <u>No Log Run</u>	
Name of Organization Running Log	

TYPE OF COMPLETION: (Circle One or More):
Gravel Packed, Underreamed, Telescoped,
Natural Development, Open Hole, Other
(Describe) _____

GEOLOGIC DATA (Office Use Only)			
Surface Elev.	Geologic Unit	Unit Thickness	Depth to Top
Subs. SWL	Date	Analysis	Aquifer Test

WELL GROUTED TO A DEPTH OF 8 FEET
Type Grout (circle one): Cement, Bentonite, or Mix

Driller's Remarks
Top of Lap Pipe or Reduction in Casing
FEET
IF TELESCOPED OR MORE THAN ONE SCREEN: USE BACK PAGE


SCREEN DATA		
Diameter - Inches <u>4"</u>	Length - Feet <u>40'</u>	Slot Size - Inches <u>.008</u>
Screen Type <u>PVC Sch 40</u>	Depth to Bottom - Feet <u>0</u>	

DESCRIPTION OF FORMATIONS ENCOUNTERED	FROM	TO	FORMATIONS (continued)	FROM	TO
<u>CLAY</u>	<u>0</u>	<u>8</u>			
<u>SAND</u>	<u>8</u>	<u>90</u>			
<u>CLAY</u>	<u>90</u>	<u>225</u>			
<u>SAND</u>	<u>225</u>	<u>300</u>			

IF MORE SPACE IS NEEDED, USE BACK

If well telescopes please sketch and show depths.

GROUND LEVEL

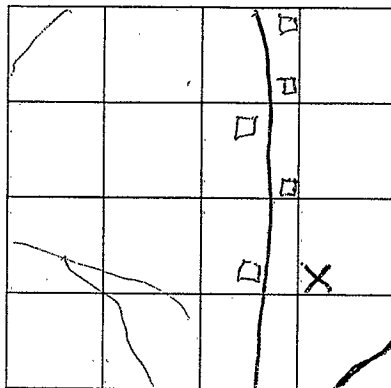

SECTION 6

Please indicate well location X.

ADDITIONAL INFORMATION

WATER RESOURCES
DIVISION

NOV 1 1970

U.S. GEOLOGICAL SURVEY
WATER RESOURCES DIVISION

If more than one screen,
show location of each on sketch.