

**MISSISSIPPI DEPARTMENT OF ENVIRONMENTAL  
QUALITY**

Office of Land and Water Resources

P. O. Box 10631  
Jackson, MS 39289-0631

**WATER WELL DRILLERS LOG**

COUNTY WELL LOCATED	
Walthall	
WELL NUMBER	CODED
G-2036	
DATE WELL COMPLETED	
5-31-00	

PERMIT NUMBER
0-621
NAME OF DRILLING FIRM
Daniel Boone

NAME & MAILING ADDRESS OF LANDOWNER			
James Magee (Dary)			
Co 36 Fordsville Rd			
Tylertown MS			
WELL LOCATION	SEC	TOWNSHIP	RANGE
	32	2	12
		N	E
		S	W
DISTANCE	DIRECTION	NEAREST TOWN	
7 Miles	E	of Tylertown	
OTHER LANDMARK			
WELL PURPOSE: Home, Irrigation, Municipal, <u>Industrial</u> , Fish Pond, etc.			

PUMP DATA			
PUMP TYPE (Circle One):			
<u>Submersible</u>	Turbine	Jet	Flowing Well
Other (Describe) _____			
POWER TYPE (Circle One):			
<u>Electric</u>	Tractor	Diesel	Gasoline
Other (Describe) _____			
Pump Capacity (GPM)	No. of Stages	Setting Depth	
22		125 FT.	
PUMP TEST			
Well yielded <u>28</u> GPM with			
a drawdown of <u>20</u> ft.			
after <u>8</u> hours of pumping			

WELL DATA		
Well Depth	Casing Diameter (In )	Casing Length (Ft.)
160	4"	130
Type of Casing	Hole Depth	Depth to Static Water Level
PVC	160	90'
TYPE OF COMPLETION: (Circle One or More):		
<u>Gravel Packed</u>	Underreamed	Telescoped
Natural Development	Open Hole	Other
(Describe) _____		
WELL GROUTED TO A DEPTH OF <u>10</u> FEET		
Type Grout (circle one): <u>Cement</u> Bentonite, or Mix		

LOG DATA	
TYPE OF LOG RUN: (Circle One):	
<u>No Log Run</u>	
Electric, Gamma-Ray, Density, Sonic, Neutron,	
Other (Describe) _____	
Name of Organization Running Log	

SCREEN DATA		
Diameter - Inches	Length - Feet	Slot Size - Inches
4"	30'	.008
Screen Type	Depth to Bottom - Feet	
PVC Sch. 40	Ø	

GEOLOGIC DATA (Office Use Only)			
Surface Elev.	Geologic Unit	Unit Thickness	Depth to Top
Subs. SWL	Date	Analysis	Aquifer Test


Driller's Remarks	
TOP OF LAP PIPE OR REDUCTION IN CASING	
FEET	
IF TELESCOPED OR MORE THAN ONE SCREEN: USE BACK PAGE	

DESCRIPTION OF FORMATIONS ENCOUNTERED	FROM	TO	FORMATIONS (Continued)	TO

**RECEIVED**  
AUG 07 2000  
Dept. of Environmental Quality  
Office of Land & Water Resources

If well telescopes please sketch and show depths.

GROUND LEVEL

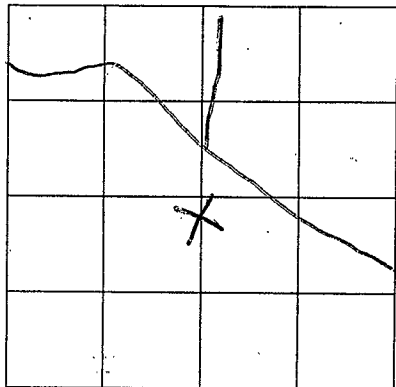

SECTION 32

Please indicate well location X.

ADDITIONAL INFORMATION

Multiple horizontal lines for additional information.

WATERBURY  
MAY 11 1984  
WATERBURY  
MAY 11 1984

If more than one screen, show location of each on sketch.