

**MISSISSIPPI
BOARD OF WATER COMMISSIONERS**
416 North State Street
Jackson, Mississippi 39201

WATER WELL DRILLERS LOG

Walthall
H
7-66

7-7 1966 Fitzgerald Water Well Service Walthall

date well completed

firm name

county well located

LANDOWNER:

Robert W. Miss

description of formations encountered

from

to

WELL LOCATION:

sec. 9 T. 1 N. R. 10 E. S. 3 miles SW of Loxley

Red Clay	0	25
Red Sand & gravel	30	35
Chalk	75	80
Soupy Sand	45	125
White Chalk	45	170
Coarse Sand & gravel	30	200
White chalk	70	-

WELL PURPOSE: *7-67 sand & gravel*
(home, irrigation, municipal, industrial)


WELL COMPLETION DATA:

- (1) diameter (inches) 4
- (2) total depth (feet) 196
- (3) static water level (feet) 25 Below above top of ground.
- (4) casing plastic (material), 188 (depth)
- (5) screen 4 (size) if telescope see back. 8' (length), 188 (depth to top)
- (6) pump 1 HP Jet (HP), 8 (yield gpm)
- (7) electric log elec (type power), No (yes or no)

(organization running log)


(8) how well bottom plugged Wood peg

DRILLERS REMARKS:

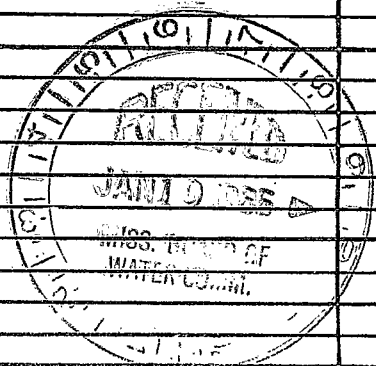

If well telescopes please sketch and show depths.

GROUND LEVEL

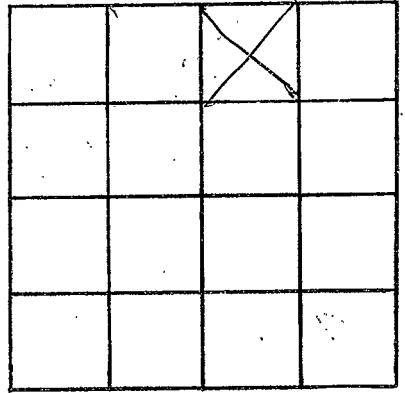

SECTION 9

Please indicate well location X.

ADDITIONAL INFORMATION

Lined area for additional information.

If more than one screen, show locations of each on sketch.