

CODED

MISSISSIPPI
BOARD OF WATER COMMISSIONERS
416 North State Street
Jackson, Mississippi 39201

WATER WELL DRILLERS LOG

Walthall
119
10-28-68

10-28 1968 Edgewood Water Works Walthall
date well completed firm name county well located

LANDOWNER: Thelma Williams

description of fomations encountered from to

Tyler Town P.M. Miss
(mailing address)

<u>top soil + clay</u>	<u>0</u>	<u>10</u>
<u>gravel + sand</u>	<u>10</u>	<u>115</u>
<u>White Chalk</u>	<u>115</u>	<u>140</u>
<u>sand + heavy gravel</u>	<u>140</u>	<u>188</u>
<u>Blue Chalk</u>	<u>188</u>	<u>260</u>
<u>Blue sand</u>	<u>260</u>	<u>290</u>

WELL LOCATION:


sec. 33 T. 1 N. R. 10 E.
8 miles SW of Tyler town
(distance) (direction) (nearest town)

WELL PURPOSE: home
(home, irrigation, municipal, industrial)

WELL COMPLETION DATA:


- (1) diameter (inches) 4
- (2) total depth (feet) 290
- (3) static water level (feet) 15 below above top of ground.
- (4) casing 4 230
(material) (depth)
4 1/2 if telescope see back.
(size)
- (5) screen _____
(length) (depth to top)
(size) (material)
- (6) pump 100
(HP) (yield gpm)
(type power)
- (7) electric log NU
(yes or no)
(organization running log)
- (8) how well bottom plugged _____

DRILLERS REMARKS:

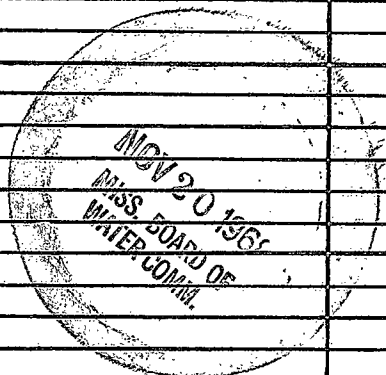

If well telescopes please sketch and show depths.

GROUND LEVEL

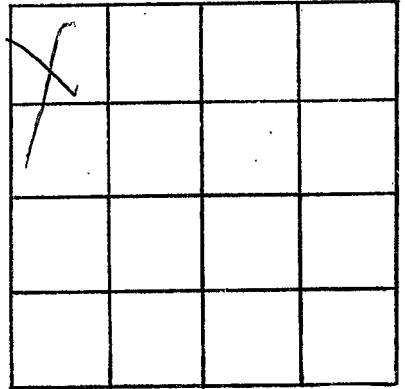

SECTION

33

Please indicate well location X.

ADDITIONAL INFORMATION

If more than one screen,
show locations of each on sketch.