

CODED

Walthall
H10
10-11-68

MISSISSIPPI
BOARD OF WATER COMMISSIONERS
416 North State Street
Jackson, Mississippi 39201

WATER WELL DRILLERS LOG

Walthall
Fitz

10-11-1968 date well completed
Fitzgerald well Inc firm name
Walthall county well located

LANDOWNER:

Eldridge Burch
R.R. Tylertown, Miss.
(mailing address)

description of formations encountered

from to

Red clay	6	15
Red sand	15	70
Red gravel	70	90
Thin sand	90	95
Coarse sand & gravel	95	106

WELL LOCATION:


sec. 25 T 7 N R 9 E
8 miles SSW of Tylertown
(distance) (direction) (nearest town)

WELL PURPOSE:

home
(home, irrigation, municipal, industrial)

WELL COMPLETION DATA:


- (1) diameter (inches) 4
- (2) total depth (feet) 106
- (3) static water level (feet) 80 below top of ground.
- (4) casing Plastic, 100 (material) (depth)
4 (size) if telescope see back.
- (5) screen 6 (length) 100 (depth to top)
4 (size) Plastic (material)
- (6) pump 7 (HP) 3 (yield gpm)
Elec (type power)
- (7) electric log Yes (yes or no)
(organization running log)
- (8) how well bottom plugged gravel peg

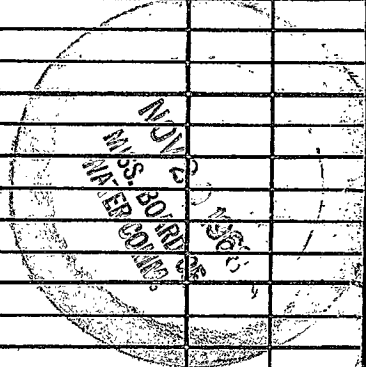

DRILLERS REMARKS:

If well telescopes please sketch and show depths.

GROUND LEVEL

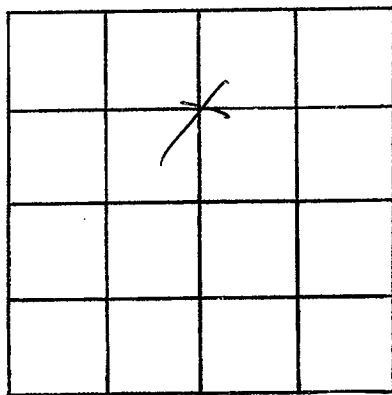

SECTION 25

Please indicate well location X.

ADDITIONAL INFORMATION

If more than one screen, show locations of each on sketch.