

60606

MISSISSIPPI  
BOARD OF WATER COMMISSIONERS  
416 North State Street  
Jackson, Mississippi 39201

Walthall  
H11  
10-22-68

WATER WELL DRILLERS LOG

10-22-68 date well completed  
Edgewood Water Well firm name  
Walthall county well located

LANDOWNER: DD Montiponn

Tylertown R 10 M

(mailing address)

description of formations encountered

from

to

top soil & clay 0 18  
Red sand 18 60  
sand & gravel 60 75  
Chert 75 75


WELL LOCATION:

sec. 3 T. 1 N. R. 10 E.  
S W  
4 miles So of Tylertown  
(distance) (direction) (nearest town)

WELL PURPOSE: home  
(home, irrigation, municipal, industrial)

WELL COMPLETION DATA:


- (1) diameter (inches) 4
- (2) total depth (feet) 73
- (3) static water level (feet) 35 below top of ground.
- (4) casing plastic 67 (material) (depth)  
4" if telescope see back. (size)
- (5) screen 6' 67' (length) (depth to top)  
4" Sch 40 (size) (material)
- (6) pump 1 (HP) 1 (yield gpm)  
Spec (type power)
- (7) electric log No (yes or no)  
W. J. Payne (organization running log)
- (8) how well bottom plugged

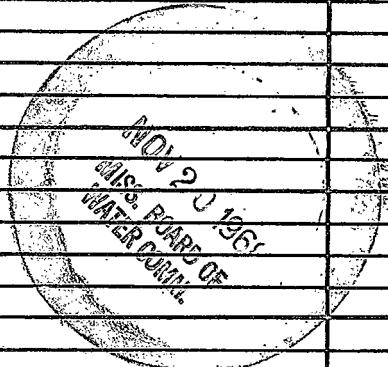

DRILLERS REMARKS:

If well telescopes please sketch and show depths.

GROUND LEVEL

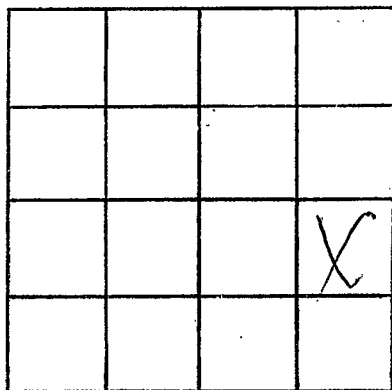

SECTION 2

Please indicate well location X.

ADDITIONAL INFORMATION

If more than one screen, show locations of each on sketch.